

Harrison  
H 222  
5-5-75

MISSISSIPPI  
 BOARD OF WATER COMMISSIONERS  
 416 North State Street  
 Jackson, Mississippi 39201

WATER WELL DRILLERS LOG  
 COASTAL DRILLING & SERVICE CO.

CODED.

5/5/75 19  
 date well completed

ROUTE 1 BOX 618  
 firm name

Harrison  
 county well located

BILOXI, MISS. 39532

LANDOWNER:

description of formations encountered

from to

Dr. Robert Griffith  
69 Orchard Dr.  
J. Bilsee, Jr.  
 (mailing address)

<u>Top Soil</u>	1	3
<u>Red Sand</u>	3	20
<u>White Sand + Clay</u>	20	220
<u>Soft Blue Clay</u>	220	340
<u>Hard Clay</u>	340	540
<u>Shill</u>	540	545
<u>hard blue clay</u>	545	570
<u>hard</u>	570	575
<u>hard Rock</u>	575	580
<u>hard blue clay</u>	580	600
<u>fine water sand</u>	600	620
<u>fine water sand</u>	620	630
<u>hard clay</u>	630	635
<u>Coast water sand</u>	635	766

WELL LOCATION:

sec. 32 6/5 R. 7 E. 135 W.  
2 1/2 miles E Cedar Lake of 135 (distance) (direction) (nearest town)

WELL PURPOSE:

Drinking  
 (home, irrigation, municipal, industrial)

WELL COMPLETION DATA:

- (1) diameter (inches) 2"
- (2) total depth (feet) 766
- (3) static water level (feet) 6" below top of ground.
- (4) casing POC 75'  
 (material) (depth)
- (5) screen 15' 75'  
 (length) (depth to top)  
2" POC  
 (size) (material)
- (6) pump 1 HP 20  
 (HP) (yield gpm)  
Ele  
 (type power)
- (7) electric log no  
 (yes or no)

(organization running log)

(8) how well bottom plugged

2" bottom with valve


DRILLERS REMARKS:

RECEIVED  
 JUL 17 1975

MISS. BD. OF WATER

If well telescopes please sketch and show depths.

GROUND LEVEL

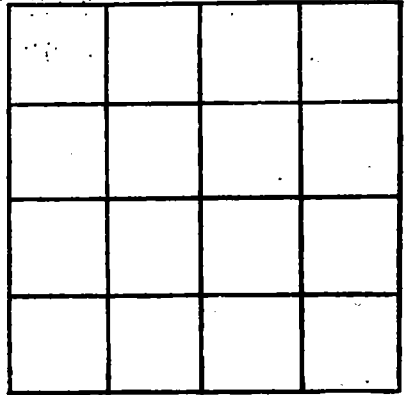

SECTION \_\_\_\_\_

Please indicate well location X.

ADDITIONAL INFORMATION

If more than one screen, show locations of each on sketch.