

MISSISSIPPI DEPARTMENT OF NATURAL RESOURCES

Bureau of Land and Water Resources

Southport Mall

P.O. Box 10631

Jackson, Mississippi 39209

WATER WELL DRILLERS LOG

CODED

Harrison  
~~Jackson~~  
 H 224  
 3/12/81

3/12/81 date well completed  
 Lyman Well Co. firm name  
 Harrison county well located

LANDOWNER: Harvey Lamey  
16001 - The Clellan Rd  
Latimer, MS 39532  
 (mailing address)


description of formations encountered	from	to
yellow clay	0	6
white clay	6	25
grey clay & blue sand	25	350
SAND (very fine)	350	460
Blue clay	460	740
SAND & clay strip	740	920
clay	920	1020
SAND 30ft good	1020	1070

WELL LOCATION:  
 sec. 28 T. 6 N. R. 9 E.  
8 miles NE of Biloxi  
 (distance) (direction) (nearest town)

WELL PURPOSE: home  
 (home, irrigation, municipal, industrial)

WELL COMPLETION DATA:

- (1) diameter (inches) 2"
- (2) total depth (feet) 1071'
- (3) static water level (feet) +18' below top of ground.
- (4) casing PVC, 1061'  
 (material) (depth)  
2" if telescope see back.  
 (size)
- (5) screen 10', 1061'  
 (length) (depth to top)  
2" PVC  
 (size) (material)
- (6) pump well flowing, 40 gpm  
 (HP) (yield gpm)
- (type power)
- (7) electric log No  
 (yes or no)  
No  
 (organization running log)
- (8) how well bottom plugged sand  
Shark

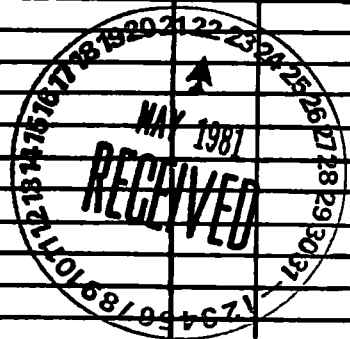

DRILLERS REMARKS: Existing  
well over 1100 ft 40  
year old pumping SAND

