

MISSISSIPPI DEPARTMENT OF NATURAL RESOURCES

Bureau of Land and Water Resources

Southport Mall

P.O. Box 10631

Jackson, Mississippi 39209

WATER WELL DRILLERS LOG

CODED

H225
HARRISON
7-16-83

17/16/83 1983 Clymer Well Co. firm name HARRISON county well located

LANDOWNER: Mocking Bird
TRI. PARK
Bellevue, Md
(mailing address)

description of formations encountered	from	to
<u>fine sand gravel shells</u>	<u>0</u>	<u>140</u>
<u>Blue Gumbo Clay</u>	<u>140</u>	<u>260</u>
<u>fine sand</u>	<u>260</u>	<u>302</u>
<u>blue clay</u>	<u>302</u>	<u>400</u>
<u>good sand</u>	<u>400</u>	<u>468</u>

WELL LOCATION:
sec 15 T 6 N R 10 E
5 miles W of GREENSBORO
(distance) (direction) (nearest town)

WELL PURPOSE: MUNICIPAL
(home, irrigation, municipal, industrial)

- WELL COMPLETION DATA:
- (1) diameter (inches) 1 1/2 x 2
 - (2) total depth (feet) 468
 - (3) static water level (feet) 60' above top of ground.
 - (4) casing PVC, 438,
(material) (depth)
4 1/2 if telescope see back.
(size)
 - (5) screen 30', 468
2 1/2 (length) (depth to top)
2, PVC
(size) (material)
 - (6) pump 2, 48
(HP) (yield gpm)
Elect.
(type power)
 - (7) electric log NO
(yes or no)
NO
(organization running log)
 - (8) how well bottom plugged shut


DRILLERS REMARKS:

DEPT. OF NATURAL RESOURCES
BUREAU OF LAND & WATER RESOURCES

NOV - 8 1983
RECEIVED

If well telescopes please sketch and show depths.

GROUND LEVEL

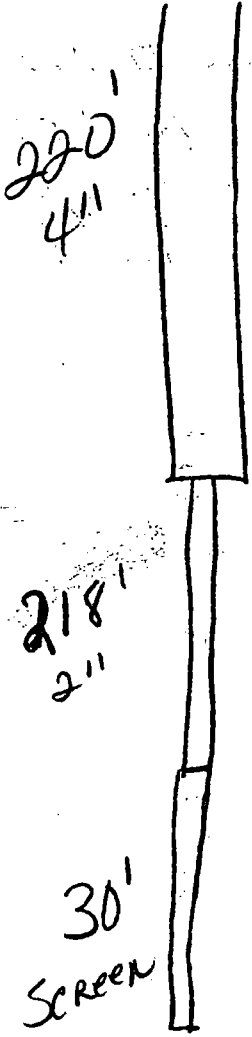

SECTION _____

Please indicate well location X.

ADDITIONAL INFORMATION

If more than one screen, show locations of each on sketch.