

Harrison  
 H 229  
 7-9-75

MISSISSIPPI  
 BOARD OF WATER COMMISSIONERS  
 416 North State Street  
 Jackson, Mississippi 39201

**CODED**

WATER WELL DRILLERS LOG

HARRISON

9 July 1975 Bryant Well Co  
 date well completed firm name county well located

LANDOWNER: L.E. Husley  
 RT 2 Box 402  
 Biloxi, Ms. 39532  
 (mailing address)

description of formations encountered	from	to
clay	0	18
RED SAND	18	60
WHITE CLAY	60	114
FINE SAND	114	126
CLAY W/ SAND STREAKS	126	181
BLUE CLAY	181	295
GOOD SAND	295	331

WELL LOCATION:  
 sec 26 T 6 S R 12 W  
 5 miles NW of Biloxi  
 (distance) (direction) (nearest town)

WELL PURPOSE:  
 home irrigation, municipal, industrial

WELL COMPLETION DATA:

(1) diameter (inches) 2

(2) total depth (feet) 330

(3) static water level (feet) 57 below top of ground above

(4) casing PVC 321 (material) (depth)  
 (size) If telescope see back.

(5) screen 10' 321 (length) (depth to top)  
 010" PVC (size) (material)

(6) pump 1 10 (HP) (yield gpm)  
 ELECT (type power)

(7) electric log NO (yes or no)

(organization running log)

(8) how well bottom plugged SAND  
 9422K

**CODED**


RECORDED  
 INDEXED  
 SEP - 8 1975

MISS. BD. OF WATER COMM

DRILLERS REMARKS:

If well telescopes please sketch and show depths.

GROUND LEVEL

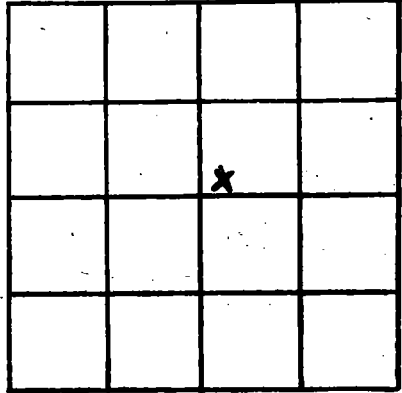

SECTION 26

Please indicate well location X.

ADDITIONAL INFORMATION

If more than one screen, show locations of each on sketch.