

MISSISSIPPI DEPARTMENT OF NATURAL RESOURCES

Bureau of Land and Water Resources

Southport Mall

P.O. Box 10631

Jackson, Mississippi 39209

CODED

COASTAL WATER WELL DRILLERS LOG

ROUTE 1 BOX 618

BILOXI, MISS. <sup>firm name</sup> 39532

Harrison  
county well located

HARRISON  
H 235  
5-28-79

5/28/79  
date well completed

LANDOWNER:

Shirley Wright  
Rt 1 Box 618

description of formations encountered

from to

Biloxi Way Mill Rd  
(mailing address)

|                          |            |            |
|--------------------------|------------|------------|
| <u>top soil</u>          | <u>1</u>   | <u>3</u>   |
| <u>Soft Red Clay</u>     | <u>3</u>   | <u>15</u>  |
| <u>Green Sand</u>        | <u>15</u>  | <u>20</u>  |
| <u>Coarse water sand</u> | <u>40</u>  | <u>75</u>  |
| <u>Soft Blue Clay</u>    | <u>75</u>  | <u>210</u> |
| <u>fine water sand</u>   | <u>210</u> | <u>240</u> |
| <u>Hard Blue Clay</u>    | <u>240</u> | <u>260</u> |
| <u>fine water sand</u>   | <u>260</u> | <u>480</u> |
| <u>Coarse water sand</u> | <u>480</u> | <u>528</u> |

WELL LOCATION:

sec 28 T 6 N R 10 E  
S W  
Mill Creek  
(distance) (direction) (nearest town)

WELL PURPOSE:

home  
(home, irrigation, municipal, industrial)

WELL COMPLETION DATA:

- (1) diameter (inches) 4 1/2"
- (2) total depth (feet) 528'
- (3) static water level (feet) 90' below above top of ground.
- (4) casing PVC 513'  
" (material) (depth)  
4 1/2" If telescope see back.  
(size)
- (5) screen 15' 513'  
(length) (depth to top)  
24 PVC  
(size) (material)
- (6) pump 1 1/2 25 ham  
(HP) (yield gpm)  
Ele  
(type power)
- (7) electric log no  
(yes or no)

(organization running log)

(8) how well bottom plugged

2" lead wire valve

DRILLERS REMARKS: 19-B

DEPT. OF NATURAL RESOURCES  
BUREAU OF LAND & WATER RESOURCES

OCT 3 + 1980

RECEIVED

If well telescopes please sketch and show depths.


GROUND LEVEL

180' 4" PVC Casing

333' 2" PVC Casing

15' 2" Screen

2" back wash valves  
19-B

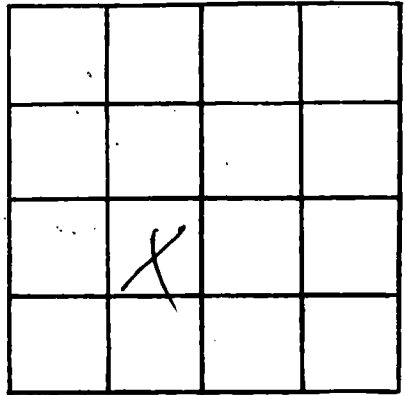

SECTION \_\_\_\_\_

Please indicate well location X.

ADDITIONAL INFORMATION

If more than one screen,  
show locations of each on sketch.