

MISSISSIPPI DEPARTMENT OF NATURAL RESOURCES

Bureau of Land and Water Resources

Southport Mall

P.O. Box 10631

Jackson, Mississippi 39209

WATER WELL DRILLERS LOG
COASTAL DRILLING & SERVICE CO.

ROUTE 1 BOX 618

firm name
BILLOXT, MISS. 39532

county well located

CODED

HARRISON
H 236
6-3-80

date well completed

6/3/80

LANDOWNER: Dw Loney

description of formations encountered

from to

Hwy 67 Rt 5
Biloxi Min
(mailing address)

<u>top soil</u>	<u>1</u>	<u>3</u>
<u>red clay</u>	<u>3</u>	<u>15</u>
<u>Super Sand</u>	<u>15</u>	<u>25</u>
<u>College white Sand</u>	<u>25</u>	<u>65</u>
<u>Soft Blue Clay</u>	<u>65</u>	<u>230</u>
<u>hard Blue Clay</u>	<u>230</u>	<u>430</u>
<u>fine water Sand</u>	<u>430</u>	<u>450</u>
<u>good water Sand</u>	<u>450</u>	<u>490</u>
<u>hard Blue Clay</u>	<u>490</u>	<u>630</u>
<u>hard rock</u>	<u>630</u>	<u>635</u>
<u>fine water Sand</u>	<u>635</u>	<u>660</u>
<u>fine water Sand</u>	<u>660</u>	<u>680</u>
<u>fine water Sand</u>	<u>680</u>	<u>730</u>

WELL LOCATION:

sec. 15 T. 6 S. R. 10 E
4 miles North of Coalville
(distance) (direction) (nearest town)

WELL PURPOSE: home
(home, irrigation, municipal, industrial)

WELL COMPLETION DATA:

- (1) diameter (inches) 4"
- (2) total depth (feet) 730'
- (3) static water level (feet) 40 below above top of ground.
- (4) casing Steel, 700' (material) (depth)
If telescope see back.
(size)
- (5) screen 30', 700' (length) (depth to top)
4", SS. (size) (material)
- (6) pump 3HP, 35 (HP) (yield gpm)
Ele (type power)
- (7) electric log no (yes or no)

(organization running log)

(8) how well bottom plugged
check well detail


DRILLERS REMARKS:

Real good well

RECEIVED

If well telescopes please sketch and show depths.

GROUND LEVEL

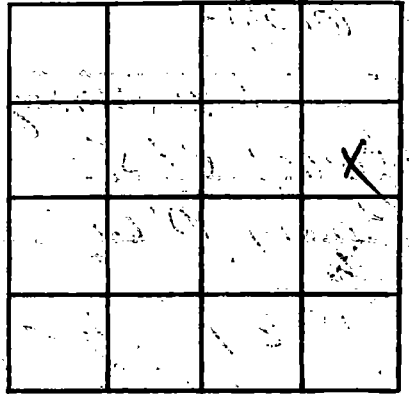

SECTION _____

Please indicate well location X.

ADDITIONAL INFORMATION

If more than one screen, show locations of each on sketch.