

H 238

221301

11-238

CODED

WATER WELL DRILLERS LOG

11-15-63

Date: Nov 15, 1963, Driller: Satterberg Butts County Harrison (Name)

(1) Owner of Land: Jacob Ramsey Sr
 (Name)
Box 273 Sasser, Miss.
 (Address)

(2) Location: SW 3/4 DIV 23 T65 R100
Ramsey Settlement
7 miles W of WPT
 (distance) (direction) (Nearest Town)

(3) Topography: 523 T065 R10W
 (Hilly) (Flat) (Level)

(4) Purpose of Well: domestic
 (Domestic Irrigation
 Municipal, Industrial, Other)

Description & Color of Materials Sand, Clay, Red Clay, Shell, etc.	Thick- ness Feet	Depth Feet
Red clay	0 - 25	
Red sand	25 - 130	
Blue clay	130 - 183	
Blue sand	183 - 190	
Wellcine Over May 67 - Town 13-10-63		

Information upon completion of well:

(1) Diameter 2 inches.

(2) Total Depth 190 feet.

(3) Water Level 66 feet below top of ground.

(4) Cased to _____, Size _____


(5) Screen: Size 2", Length 5'

(6) Were any formations sealed against pollution?
 _____ yes, _____ no.

If YES depth of formation _____

Why _____

Drillers Remarks: _____

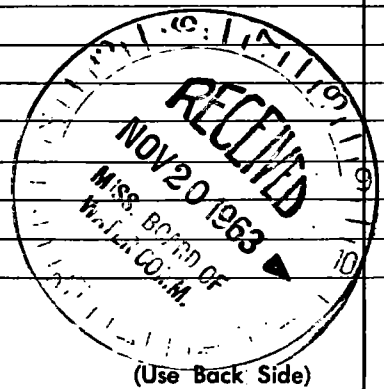

(Use Back Side)

Well No.

