

MISSISSIPPI DEPARTMENT OF NATURAL RESOURCES

Bureau of Land and Water Resources

Southport Mall

P.O. Box 10631

Jackson, Mississippi 39209

WATER WELL DRILLERS LOG

H241  
Harrison Co  
2-26-84

CODED

2/20/84 19 date well completed

Bradley Pump & Well Sew. Inc. firm name

Harrison county well located

LANDOWNER: James Hallia

description of formations encountered

from

to

Three Rivers Rd.  
Biloxi, Ms. 39532  
(mailing address)

sandy clay	0	20
sand + clay	20	40
red clay	40	80
sand + sh. clay	80	120
green clay	120	180
gr. clay + sand	180	200
green clay	200	380
sand	380	400
med. sand	400	420
sand	420	430

WELL LOCATION:

sec. 18 T. 6 S. R. 10 W.  
7 miles N.E. of Woodmark  
(distance) (direction) (nearest town)

WELL PURPOSE: home  
(home, irrigation, municipal, industrial)

WELL COMPLETION DATA:

- (1) diameter (inches) 2"
- (2) total depth (feet) 430'
- (3) static water level (feet) 70 below top of ground
- (4) casing PVC 410 (material), (depth)  
2" (size) if telescope see back.
- (5) screen 10' (length), 410 (depth to top)  
2" (size), PVC underbar (material)
- (6) pump 1 (HP), 8 (yield gpm)  
930 (type power)
- (7) electric log no (yes or no)

(organization running log)

(8) how well bottom plugged PVC underbar sandbar


DRILLERS REMARKS: 10 ft tailpipe

DEPT. OF NATURAL RESOURCES  
BUREAU OF LAND & WATER RESOURCES

RECEIVED

If well telescopes please sketch and show depths.

GROUND LEVEL

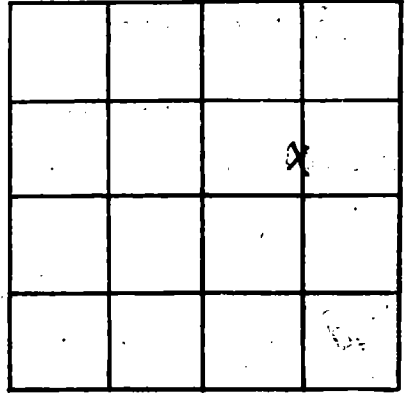

SECTION B

Please indicate well location X.

ADDITIONAL INFORMATION

If more than one screen, show locations of each on sketch.