

MISSISSIPPI DEPARTMENT OF NATURAL RESOURCES

Bureau of Land and Water Resources

Southport Mall

P.O. Box 10631

Jackson, Mississippi 39209

WATER WELL DRILLERS LOG

ROUTE 1 BOX 618

BILOXI, MISS. 39532

county well located

H 242  
Harrison Co.  
4-7-83

CODED

4/7/83 19  
date well completed

*Harrison*

LANDOWNER: *Small Balance*

description of formations encountered

from

to

*Hyp 15*  
*Biloxi MS 39532*  
(mailing address)

<i>Top Soil</i>	<i>1</i>	<i>3</i>
<i>Red Clay</i>	<i>3</i>	<i>18</i>
<i>white sand</i>	<i>18</i>	<i>35</i>
<i>Soft white clay</i>	<i>35</i>	<i>50</i>
<i>Sandstone</i>	<i>50</i>	<i>90</i>
<i>Soft Blue Clay</i>	<i>90</i>	<i>210</i>
<i>Hard Blue Clay</i>	<i>210</i>	<i>280</i>
<i>fine water sand</i>	<i>280</i>	<i>300</i>
<i>hard water sand</i>	<i>300</i>	<i>320</i>

WELL LOCATION:

sec *20* T. *6* N. R. *9* E. S. *5* W.  
*1/2* mile North parallel line  
(distance) (direction) (nearest town)

WELL PURPOSE: *Home*  
(home, irrigation, municipal, Industrial)

WELL COMPLETION DATA:

- (1) diameter (inches) *4 1/2"*
- (2) total depth (feet) *320'*
- (3) static water level (feet) *30* below above top of ground
- (4) casing *PVC* *305'*  
(material) (depth)
- 4 1/2"*  
(size) If telescope see back.
- (5) screen *15'* *305'*  
(length) (depth to top)
- 2"* *PVC*  
(size) (material)
- (6) pump *1/2* *22*  
(HP) (yield gpm)
- Ele*  
(type power)
- (7) electric log *yes*  
(yes or no)

(organization running log)

(8) how well bottom plugged  
*2 feet with water*  
DRILLERS REMARKS: *19-B*

DEPT. OF NATURAL RESOURCES  
BUREAU OF LAND & WATER RESOURCES

MAR 29 1984

RECEIVED

If well telescopes please sketch and show depths.

GROUND LEVEL


160' 4" PVC casing

145' 2" PVC casing

15' 2" PVC screen

2' galvanized pipe  
19-B

If more than one screen, show locations of each on sketch.

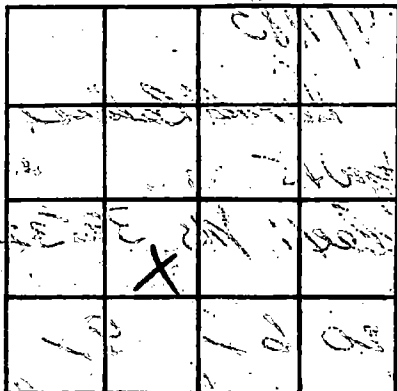

SECTION \_\_\_\_\_

Please indicate well location X.

ADDITIONAL INFORMATION

Multiple horizontal lines for additional information.