

MISSISSIPPI DEPARTMENT OF NATURAL RESOURCES

Bureau of Land and Water Resources

Southport Mall

P.O. Box 10631

Jackson, Mississippi 39209

WATER WELL DRILLERS LOG
COASTAL DRILLING & SERVICE CO.

ROUTE 1 BOX 618

Harrison
county well located

BLDGT name MISS. 30532

H 247
Harrison
6-4-83

6/4/83
date well completed

LANDOWNER: *H.W. Rehrig*

John Lee Road

Rt 5 Bikesi MS
(mailing address)

description of formations encountered

from to

<i>top soil</i>	<i>1</i>	<i>3</i>
<i>red clay</i>	<i>3</i>	<i>15</i>
<i>white sand</i>	<i>15</i>	<i>40</i>
<i>Soft Blue Clay</i>	<i>40</i>	<i>210</i>
<i>gray sand</i>	<i>210</i>	<i>250</i>
<i>hard blue clay</i>	<i>250</i>	<i>350</i>
<i>fine water sand</i>	<i>350</i>	<i>360</i>
<i>Coarse water sand</i>	<i>360</i>	<i>395</i>

WELL LOCATION:

sec *19* T. *6* N R. *10* E

Mill Creek
(distance) (direction) (nearest town)

WELL PURPOSE:

(home, irrigation, municipal, industrial) *home*

WELL COMPLETION DATA:

- (1) diameter (inches) *2"*
- (2) total depth (feet) *395'*
- (3) static water level (feet) *40'* below above top of ground.

- (4) casing *pic* *385'*
(material) (depth)

(size) if telescope see back.

- (5) screen *10'* *385'*
(length) (depth to top)

2" *pic*
(size) (material)

- (6) pump *1/2* *14*
(HP) (yield gpm)

Ele
(type power)

- (7) electric log *no*
(yes or no)

(organization running log)

- (8) how well bottom plugged *2' shallow value*

DRILLERS REMARKS: *17-12*


DEPT. OF NATURAL RESOURCES
BUREAU OF LAND & WATER RESOURCES

MAR 29 1984

RECEIVED

If well telescopes please sketch and show depths.

GROUND LEVEL

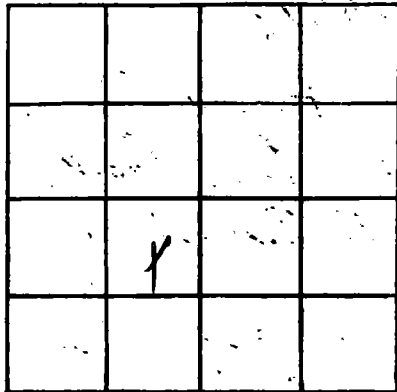

SECTION _____

Please indicate well location X.

ADDITIONAL INFORMATION

If more than one screen, show locations of each on sketch.