

MISSISSIPPI DEPARTMENT OF NATURAL RESOURCES

Bureau of Land and Water Resources

Southport Mall

P.O. Box 10631

Jackson, Mississippi 39209

WATER WELL DRILLERS LOG

CODED

H249
 HARRISON
 10-6-83

10/6/83 19 Lyman Well Co. Harrison
 date well completed firm name county well located

LANDOWNER: Pat McInnis
Rt. 2, Box 576-B
Biloxi 39532
 (mailing address)

| description of formations encountered | from | to |
|---------------------------------------|------|-----|
| Red sand & Clay | 0 | 60 |
| Blue Clay | 60 | 280 |
| fine powder sand | 280 | 260 |
| Blue Clay | 260 | 340 |
| Sand Clay STREAKS | 340 | 380 |
| Medium to fine sand | 380 | 400 |
| Good sand | 400 | 430 |

WELL LOCATION:
 sec. 34 T 6 N R 10 E
13 miles NW of Biloxi
 (distance) (direction) (nearest town)

WELL PURPOSE: Home
 (home, irrigation, municipal, industrial)


- WELL COMPLETION DATA:
- (1) diameter (inches) 2"
 - (2) total depth (feet) 430'
 - (3) static water level (feet) 74' below above top of ground.
 - (4) casing PVC, 420'
 (material) (depth)
2" If telescope see back.
 (size)
 - (5) screen 10', 420'
 (length) (depth to top)
2", PVC
 (size) (material)
 - (6) pump 1, 10
 (HP) (yield gpm)
electric
 (type power)
 - (7) electric log No
 (yes or no)
No
 (organization running log)
 - (8) how well bottom plugged sand
shark

DRILLERS REMARKS: Sand is
Good But Can be difficult
To develop if not
watched closely

MISSISSIPPI DEPARTMENT OF NATURAL RESOURCES
 BUREAU OF LAND & WATER RESOURCES
RECEIVED
 APR 26 1984

If well telescopes please sketch and show depths.

GROUND LEVEL

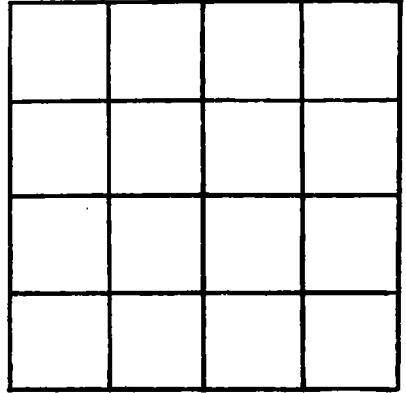

SECTION _____

Please indicate well location X.

ADDITIONAL INFORMATION

If more than one screen, show locations of each on sketch.