

HARRISON
H 252

MISSISSIPPI DEPARTMENT OF NATURAL RESOURCES

Bureau of Land and Water Resources

Southport Mall

P.O. Box 10631

Jackson, Mississippi 39209

WATER WELL DRILLERS LOG

COASTAL DRILLING & SERVICE CO.

CODED

11/20/83
date well completed

ROUTE 1 BOX 618
firm name

Harrison
county well located

BILOXI, MISS 39532

LANDOWNER: A.P. Ghatt

description of formations encountered

from to

Rt 2 Box 618

Biloxi sons
(mailing address)

description of formations encountered	from	to
Top Soil	1	3
Red Clay	3	15
White Sand	15	40
Grey Sand	40	65
Soft Blue Clay	65	210
Hard Blue Clay	210	270
Free water Sand	270	280
Soft water Sand	280	310

WELL LOCATION:

sec 13 T 6 N R 10 E
Worsham
(distance) (direction) (nearest town)

WELL PURPOSE: home
(home, irrigation, municipal, industrial)

WELL COMPLETION DATA:

- (1) diameter (inches) 2"
- (2) total depth (feet) 310'
- (3) static water level (feet) 40' below top of ground
- (4) casing PVC, 300' (depth)
- (size) If telescope see back.
- (5) screen 10' 300' (length) (depth to top)
- 2" PVC (size) (material)
- (6) pump None 12 (HP) (yield gpm)
- cle (type power)
- (7) electric log no (yes or no)

CODED

(organization running log)

(8) how well bottom plugged
2" back wash valve

DRILLERS REMARKS: 19A


DEPT. OF NATURAL RESOURCES
BUREAU OF LAND & WATER RESOURCES

NOV 8 1984

RECEIVED

If well telescopes please sketch and show depths.

GROUND LEVEL

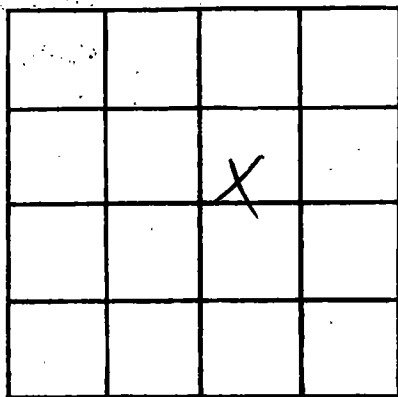

SECTION _____

Please indicate well location X.

ADDITIONAL INFORMATION

If more than one screen, show locations of each on sketch.