

HARRISON
H253

MISSISSIPPI DEPARTMENT OF NATURAL RESOURCES
Bureau of Land and Water Resources
Southport Mall
P.O. Box 10631

Jackson, Mississippi 39209
WATER WELL DRILLERS LOG
COASTAL DRILLING & SERVICE CO.
ROUTE 1 BOX 618
firm name
Biloxi, Miss. 39532
county well located

CODED

12/15/83
date well completed 19

LANDOWNER WW. Wentz
Rt 5 Walnut Fork
Biloxi MS 39532
(mailing address)

description of formations encountered	from	to
top soil	1	3
red clay	3	15
gray soil	15	60
blue white sand	60	75
hard blue clay	75	210
fine water sand	210	225
good water sand	225	260

WELL LOCATION:
sec. 33 T. 6 N. R. 10 E.
Walnut Fork
(distance) (direction) (nearest town)

WELL PURPOSE: Home
(home, irrigation, municipal, industrial)

WELL COMPLETION DATA:

- diameter (inches) 2"
- total depth (feet) 260'
- static water level (feet) 25' below top of ground.
- casing PVC, 250'
(material) (depth)
(size) If telescope see back.
- screen 10', 250'
(length) (depth to top)
2", PVC
(size) (material)
- pump None, 12
(HP) (yield gpm)
5hp
(type power)
- electric log No
(yes or no)
(organization running log)

(8) how well bottom plugged
2" back wash valve

DRILLERS REMARKS:

CODED


DEPT. OF NATURAL RESOURCES
BUREAU OF LAND & WATER RESOURCES

NOV 8 1983

RECEIVED

If well telescopes please sketch and show depths.

GROUND LEVEL

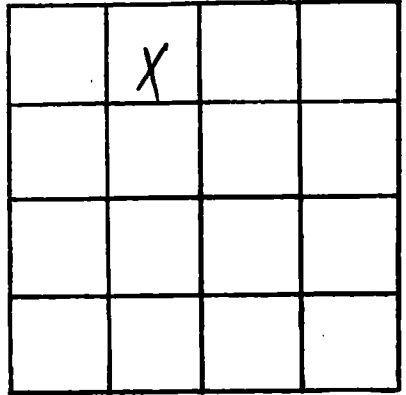

SECTION _____

Please indicate well location X.

ADDITIONAL INFORMATION

If more than one screen, show locations of each on sketch.