

MISSISSIPPI DEPARTMENT OF NATURAL RESOURCES

Bureau of Land and Water Resources

Southport Mall

P.O. Box 10631

Jackson, Mississippi 39209

WATER WELL DRILLERS LOG
COASTAL DRILLING & SERVICE CO.

ROUTE 1 BOX 618

firm name
BILOXI, MISS. 39532

county well located

CODED

HARRISON
H254

11/28/83
date well completed

Harrison
county well located

LANDOWNER: M.L. Colinton

description of formations encountered

from to

Rt 2 Box 249-B13

Top Soil	1	3
Red Clay	3	15
gray sand	15	35
hard blue clay	35	265
fine white sand	265	285
good water sand	285	300

Tilley's Docs
(mailing address)

WELL LOCATION:

sec 36 T 6 N R 10 E
S W

0.5 miles (distance) of (direction) (nearest town)
Columbus

WELL PURPOSE: home
(home, irrigation, municipal, industrial)

WELL COMPLETION DATA:

- (1) diameter (inches) 2"
- (2) total depth (feet) 300'
- (3) static water level (feet) 25' below above-top of ground.
- (4) casing PVC 290'
(material) (depth)

(size) If telescope see back.

- (5) screen 10' 290'
(length) (depth to top)

2" PVC
(size) (material)

- (6) pump 1/2 HP 12
(HP) (yield gpm)

5 hp
(type power)

- (7) electric log No
(yes or no)

(organization running log)

- (8) how well bottom plugged
2" PVC

DRILLERS REMARKS: 19-B

CODED


DEPT. OF NATURAL RESOURCES
BUREAU OF LAND & WATER RESOURCES

NOV 8 1984

RECEIVED

If well telescopes please sketch and show depths.

GROUND LEVEL

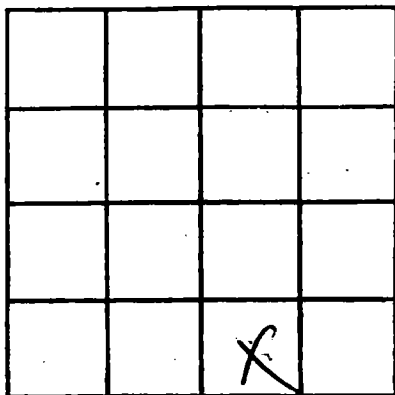

SECTION _____

Please indicate well location X.

ADDITIONAL INFORMATION

If more than one screen, show locations of each on sketch.