

MISSISSIPPI DEPARTMENT OF NATURAL RESOURCES

Bureau of Land and Water Resources

Southport Mall

P.O. Box 10631

Jackson, Mississippi 39209

WATER WELL DRILLERS LOG

CODED

H 257
Harrison
12-12-84

12/12 1984 Braden Pump & Well Sew, Inc. Harrison
date well completed firm name county well located

LANDOWNER: Lonnie Permin

Rt #2, Box 210 F
Jaucien, Mo 39574
(mailing address)

description of formations encountered

from to

| | | |
|-------------|-----|-----|
| clay & sand | 0 | 20 |
| blue clay | 20 | 240 |
| sand | 240 | 250 |
| clay (blue) | 250 | 740 |
| gray sand | 740 | 797 |

WELL LOCATION:

sec. 17 T. 6 S. R. 9 W.
8 miles NE of Woolmarket
(distance) (direction) (nearest town)

CODED

WELL PURPOSE: Home
(home, irrigation, municipal, industrial)

WELL COMPLETION DATA:

- diameter (inches) 2"
- total depth (feet) 797
- static water level (feet) 17 below top of ground
- casing PVC 777
(material) (depth)
- screen 10ft 777
(length) (depth to top)
- screen 2" PVC Underbar
(size) (material)
- pump 1 10
(HP) (yield gpm)
- electric log 230V
(type power)
- electric log no
(yes or no)

(organization running log)

(8) how well bottom plugged PVC sandshank

DRILLERS REMARKS: 10 ft

slip pipe


DEPT. OF NATURAL RESOURCES
BUREAU OF LAND & WATER RESOURCES

DEC 27 1984

RECEIVED

If well telescopes please sketch and show depths.

GROUND LEVEL

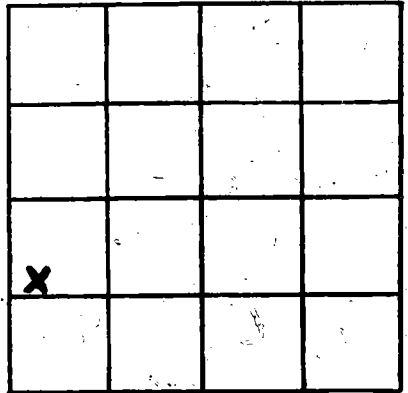

SECTION 17

Please indicate well location X.

ADDITIONAL INFORMATION

If more than one screen, show locations of each on sketch.