

MISSISSIPPI DEPARTMENT OF NATURAL RESOURCES

Bureau of Land and Water Resources

Southport Mall

P.O. Box 10631

Jackson, Mississippi 39209

WATER WELL DRILLERS LOG

CODED

Harrison
H 260
1-5-85

1-5 1985 McCall Well Works Harrison
date well completed firm name county well located

LANDOWNER: Thomas M. Little
P.O. Box 571-A
Biloxi, Ms. 39532
(mailing address)

WELL LOCATION:
sec. 31 T. 6 N. R. 9 E
15 miles NE of Biloxi
(distance) (direction) (nearest town)

WELL PURPOSE:
(home, irrigation, municipal, industrial)

WELL COMPLETION DATA:

- (1) diameter (inches) 2"
- (2) total depth (feet) 310'
- (3) static water level (feet) 30' below top of ground. above
- (4) casing Pvc. Sch 40, 300'
(material) (depth)

 If telescope see back.
(size)

- (5) screen 10', 300'
(length) (depth to top)
2", Sch. 80 - 6 slot
(size) (material)

- (6) pump 1 8
(HP) (yield gpm)

Elec
(type power)

- (7) electric log
(yes or no)

(organization running log)

- (8) how well bottom plugged SAND
SHARK

DRILLERS REMARKS:


description of formations encountered	from	to
Sand	0	20
Sand	20	40
Sand/mud	40	60
Mud CODED	60	80
Mud	80	100
Mud	100	120
Mud	120	140
Mud	140	160
Mud	160	180
Mud	180	200
Mud	200	220
Mud	220	240
Mud	240	260
Mud	260	280
Mud/Sand	280	300
Sand	300	310

RECEIVED
MAY 31 1985

Department of Natural Resources
Bureau of Land & Water Resources

If well telescopes please sketch and show depths.

GROUND LEVEL

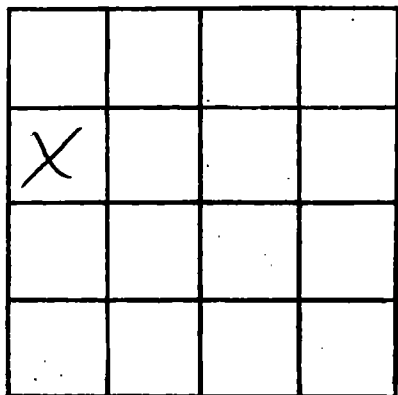

SECTION _____

Please indicate well location X.

ADDITIONAL INFORMATION

If more than one screen,
show locations of each on sketch.