

MISSISSIPPI DEPARTMENT OF NATURAL RESOURCES

Bureau of Land and Water Resources

Southport Mall

P.O. Box 10631

Jackson, Mississippi 39209 CODED

WATER WELL DRILLERS LOG

Harrison  
H261  
2-12-85

2-12-85 date well completed 1985 McMill Well Works firm name Harrison county well located

LANDOWNER: Wilton Curran  
Rt. 5 Box 655  
Gulfport Ms.  
(mailing address)

WELL LOCATION:  
sec. 19 T. 6 N. R. 10 E.  
10 miles NE of Gulfport  
(distance) (direction) (nearest town)

WELL PURPOSE:  
(home, irrigation, municipal, industrial)

WELL COMPLETION DATA:  
(1) diameter (inches) 2"  
(2) total depth (feet) 270'  
(3) static water level (feet) 40' below above top of ground.  
(4) casing Pvc Sch. 40, 260'  
(material) (depth)  
(size) if telescope see back.  
(5) screen 10', 260'  
(length) (depth to top)  
2", Sch 80 6 slot  
(size) (material)  
(6) pump 1 9  
(HP) (yield gpm)  
ELEC.  
(type power)  
(7) electric log (yes or no)  
(organization running log)  
(8) how well bottom plugged SEAL

description of formations encountered	from	to
Mud	0	20
Mud/Sand	20	40
Sand	40	60
Sand	60	80
Sand	80	100
Mud/Sand	100	120
Sand/Mud	120	140
Mud	140	160
Mud/Sand	160	180
Sand/mud	180	200
Mud	200	220
Mud/Sand	220	240
Sand	240	260
Sand	260	270


RECEIVED  
MAY 31 1985

DRILLERS REMARKS:

Department of Natural Resources  
Bureau of Land & Water Resources

If well telescopes please sketch and show depths.

GROUND LEVEL

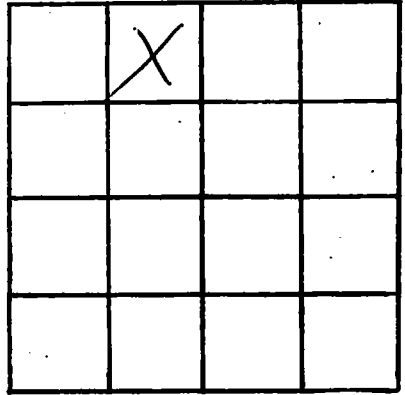

SECTION \_\_\_\_\_

Please indicate well location X.

ADDITIONAL INFORMATION

If more than one screen, show locations of each on sketch.