

MISSISSIPPI DEPARTMENT OF NATURAL RESOURCES

Bureau of Land and Water Resources

Southport Mall

P.O. Box 10631

Jackson, Mississippi 39209

CODED

WATER WELL DRILLERS LOG

Harrison
H 262
4/12/85

4-12
date well completed

1985 McKell Well Works
firm name

Harrison
county well located

LANDOWNER: Ernest W. Piper

P.O. Box 100 No 18

Biloxi, Ms. 39532
(mailing address)

WELL LOCATION:

sec. 31 T. 6 N. R. 9 E.
(S) (W)
9 miles NE of Biloxi
(distance) (direction) (nearest town)

WELL PURPOSE:

(home, irrigation, municipal, industrial)

WELL COMPLETION DATA:

- (1) diameter (inches) 2"
- (2) total depth (feet) 480'
- (3) static water level (feet) 50' below above top of ground.
- (4) casing PVC Sch 40, 470'
(material) (depth)

(size) If telescope see back.

- (5) screen 10', 470'
(length) (depth to top)
2", Sch. 80-60 slot
(size) (material)

- (6) pump 1, 7
(HP) (yield gpm)
Elec.
(type power)

- (7) electric log
(yes or no)

(organization running log)

- (8) how well bottom plugged SAND
SHARK

description of formations encountered

from to

<u>Sand</u>	<u>0</u>	<u>60</u>
<u>Sand / mud</u>	<u>60</u>	<u>100</u>
<u>Mud</u>	<u>100</u>	<u>220</u>
<u>Mud / Sand</u>	<u>220</u>	<u>280</u>
<u>Sand / Mud</u>	<u>280</u>	<u>300</u>
<u>Mud</u>	<u>300</u>	<u>400</u>
<u>Mud / Sand</u>	<u>400</u>	<u>440</u>
<u>Sand</u>	<u>440</u>	<u>480</u>

RECEIVED


JUN 4 1985

Department of Natural Resources
Bureau of Land & Water Resources

DRILLERS REMARKS:

If well telescopes please sketch and show depths.

GROUND LEVEL

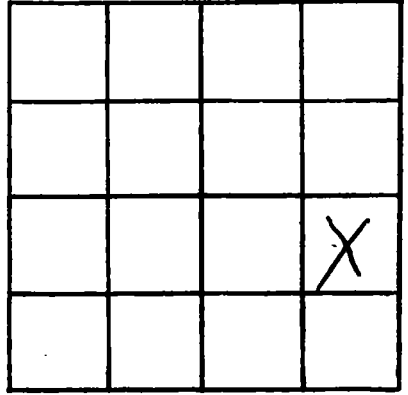

SECTION _____

Please indicate well location X.

ADDITIONAL INFORMATION

If more than one screen, show locations of each on sketch.