

MISSISSIPPI DEPARTMENT OF NATURAL RESOURCES

Bureau of Land and Water Resources

Southport Mall

P.O. Box 10631

Jackson, Mississippi 39209

WATER WELL DRILLERS LOG

CODED

Harrison
H263
4/23/85

4-23

1985

Mc Hill Well Works

Harrison

date well completed

firm name

county well located

LANDOWNER: Patricia Cook

Rural Rt. 2 Box 5756

Biloxi, Mo.
(mailing address)

WELL LOCATION:

sec. 36 T. 6 N. R. 10 E.
12 miles NE of Biloxi
(distance) (direction) (nearest town)

WELL PURPOSE:

(home, irrigation, municipal, industrial)

WELL COMPLETION DATA:

- (1) diameter (inches) 2"
- (2) total depth (feet) 200'
- (3) static water level (feet) 30' ^(below) _(above) top of ground.
- (4) casing Pvc Sch 40, 190'
(material) (depth)
(size) if telescope see back.
- (5) screen 10', 190'
(length) (depth to top)
2", Sch 80 6 slot
(size) (material)
- (6) pump 1 8
(HP) (yield gpm)
Elec.
(type power)
- (7) electric log
(yes or no)

(organization running log)
- (8) how well bottom plugged Sand
SHARK

description of formations encountered

from

to

Mud	0	20
Mud/Sand CODED	20	60
Mud	60	140
Mud/Sand	140	160
Mud	160	180
Sand	180	200

DRILLERS REMARKS:


Department of Natural Resources
Bureau of Land & Water Resources

RECEIVED

JUN - 1 1985

If well telescopes please sketch and show depths.

GROUND LEVEL

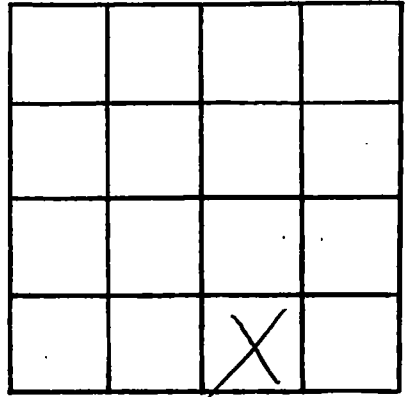

SECTION _____

Please indicate well location X.

ADDITIONAL INFORMATION

If more than one screen, show locations of each on sketch.