

MISSISSIPPI DEPARTMENT OF NATURAL RESOURCES

Bureau of Land and Water Resources

Southport Mall

P.O. Box 10631

Jackson, Mississippi 39209

WATER WELL DRILLERS LOG
COASTAL DRILLING & SERVICE CO.

CODED

Harrison
H264
5-26-84

5/26/84 19
date well completed

RT. 11, BOX 81
firm name

Harrison
county well located

CLAW, MS 39532

LANDOWNER: Woodmark Ball Club Association

Ball Park Blvd 67

Biloxi, MS

(mailing address)

WELL LOCATION:

sec. 20-T-6-N R. 9-10
S W

Highway 67

(distance) (direction) (nearest town)

WELL PURPOSE: municipal

(home, irrigation, municipal, industrial)

WELL COMPLETION DATA:

- (1) diameter (Inches) 4" x 2"
- (2) total depth (feet) 560
- (3) static water level (feet) 15 below above top of ground.

- (4) casing PVC, 545 (material) (depth)
4" x 2" (size) If telescope see back.

- (5) screen 15', 545 (length) (depth to top)
2" (size) PVC (material)

- (6) pump 3 (HP) 30 (yield gpm)
4c (type power)

- (7) electric log No (yes or no)

(organization running log)

- (8) how well bottom plugged 2" back- wash valve 19-0

description of formations encountered

from to

top soil	1	3
red clay	3	20
course white sand	20	45
hard blue clay	45	165
soft blue clay	165	260
sugar sand	260	290
hard blue clay	290	380
ROCK	380	410
soft blue clay	410	495
sugar sand	495	520
hard blue clay	520	540
fine water sand	540	550
good water sand	550	560

RECEIVED

JUL 22 1985

DRILLERS REMARKS:

Department of Natural Resources
Bureau of Land & Water Resources

If well telescopes please sketch and show depths.


GROUND LEVEL

200' 4" PVC casing

360' 2" PVC casing

15' 2" PVC screen

2" back wash valve

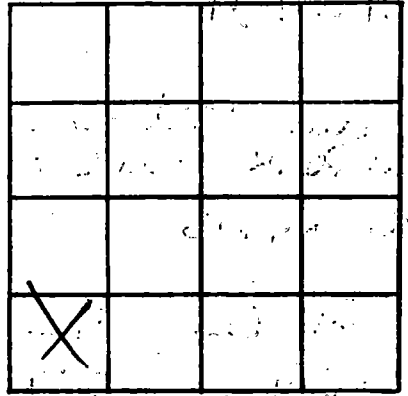

SECTION _____

Please indicate well location X.

ADDITIONAL INFORMATION

If more than one screen, show locations of each on sketch.