

MISSISSIPPI DEPARTMENT OF NATURAL RESOURCES

Bureau of Land and Water Resources

Southport Mall

P.O. Box 10631

Jackson, Mississippi 39209

WATER WELL DRILLERS LOG

COASTAL DRILLING & SERVICE CO. *Harrison*

CODED

HARRISON
H 266

8/21/84
date well completed 19

Rt. 11, Box 84

county well located

LANDOWNER: *Samuel J. ...*

description of formations encountered

from to

Rt. 3 Box 63

top soil	1	10
sugar sand	30	30
red clay	30	80
soft blue clay	80	200
course white sand	200	250
hard blue clay	250	380
soft blue clay	380	450
red clay	450	590
course white sand	590	640
hard blue clay	640	830
fine water sand	830	860
good water sand	860	870

Biola, MS
(mailing address)

WELL LOCATION:

sec. 10 T-6-N R. 10 E
S W

Biola, miles of (distance) (direction) of (nearest town)

WELL PURPOSE:

(home, irrigation, municipal, industrial) *home*

WELL COMPLETION DATA:

- (1) diameter (inches) *4" x 2"*
- (2) total depth (feet) *870*
- (3) static water level (feet) *15* below above top of ground.
- (4) casing *PVC*, *855*
(material) (depth)
4" x 2" if telescope see back.
(size)
- (5) screen *15*, *855*
(length) (depth to top)
2" (size), *PVC* (material)
- (6) pump *1*, *17 10*
(HP) (yield gpm)
ELC (type power)
- (7) electric log *NO*
(yes or no)

(organization running log)

- (8) how well bottom plugged *2" back wash valve 19-8*

RECEIVED

AUG - 5 1985

DRILLERS REMARKS:

Department of Natural Resources
Bureau of Land & Water Resources

If well telescopes please sketch and show depths.

GROUND LEVEL

160' 4" pvc casing

710' 2"


pvc casing

15' 2" pvc

screen

2" backwash valve

If more than one screen, show locations of each on sketch.

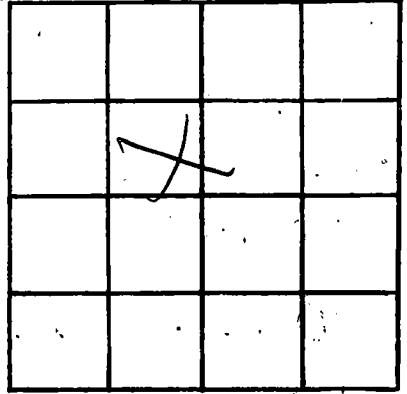

SECTION _____

Please indicate well location X.

ADDITIONAL INFORMATION

Multiple horizontal lines for additional information.