

MISSISSIPPI DEPARTMENT OF NATURAL RESOURCES

Bureau of Land and Water Resources

Southport Mall

P.O. Box 10631

Jackson, Mississippi 39209

WATER WELL DRILLERS LOG

CODED

HARRISON
J H 270

Mar 21, 86, 19 Crackwater well for Harrison
date well completed firm name county well located

LANDOWNER: Drug Corp
P.O. Box 6397

description of formations encountered from to

Bilboke, Miss.
(mailing address) 39532

Top Soil 0 1
White Clay 1 15
Blue Clay 15 210
Blue Fine Sand 210 281

WELL LOCATION:
sec 20 T 6 S R 9 E
3 1/2 miles NW of DIBERVILLE
(distance) (direction) (nearest town)

Blue Clay 281 330
Blue Clay + Oyster Shell 330 400
Blue Fine Sand 400 410
Blue Clay + Oyster Shell 410 446
Gray Coarse Sand 446 450
Blue Clay + Oyster Shell 450 475
Blue Clay 475 500
2" rock 500 550
Blue Clay 550 600
Blue Clay + Oyster Shell 600 648
Blue Clay 648 790
Blue Clay + Oyster Shell 790 815
Gray Coarse Sand 815 854
Gray Coarse Sand 854 861
Wood + Gravel

WELL PURPOSE: Home
(home, irrigation, municipal, industrial)

WELL COMPLETION DATA:
(1) diameter (inches) 2"
(2) total depth (feet) 861
(3) static water level (feet) 20' below Flow 20' above top of ground.
(4) casing PVC, 836,
(material) (depth)
2"
(size) if telescope see back.
(5) screen 20', 816
(length) (depth to top)
2", PVC
(size) (material)
(6) pump 1/2 h.p.,
(HP) (yield gpm)
Elect.
(type power)
(7) electric log no
(yes or no)
(organization running log)
(8) how well bottom plugged
Backwater valve


DRILLERS REMARKS: 5 ft 2" tail pipe

CODED

Department of Natural Resources
Bureau of Land & Water Resources

If well telescopes please sketch and show depths.

GROUND LEVEL

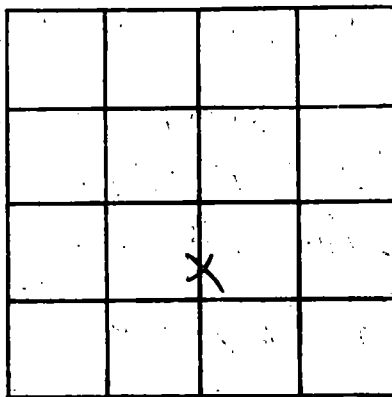

SECTION 20

Please indicate well location X.

ADDITIONAL INFORMATION

If more than one screen, show locations of each on sketch.