

COUNTY WELL LOCATED
Harrison

WELL NUMBER
H 290

DATE WELL COMPLETED
10-20-95

PERMIT NUMBER

NAME OF DRILLING FIRM
Coastwater Well Service

MISSISSIPPI DEPARTMENT OF ENVIRONMENTAL QUALITY
Office of Land and Water Resources

P. O. Box 10631
Jackson, MS 39289-0631
WATER WELL DRILLERS LOG

NAME & MAILING ADDRESS OF LANDOWNER
John Buterich
Hwy 67
Woolmarket Ms.

WELL LOCATION: SEC TOWNSHIP RANGE
SESE 34 6 N 10 E W

DISTANCE DIRECTION NEAREST TOWN
1 1/2 Miles EAST of Woolmarket

OTHER LANDMARK

WELL PURPOSE: Home, Irrigation, Municipal, Industrial, Fish Pond, etc.
OFFICE BLDG

PUMP DATA

PUMP TYPE (Circle One):
Submersible, Turbine, **Flowing Well**, Other (Describe)

POWER TYPE (Circle One):
Electric, Tractor, Diesel, Gasoline, Butane, Other (Describe) **H/P**

Pump Capacity (GPM) No. of Stages Setting Depth
10 2 FT.

PUMP TEST
Well yielded _____ GPM with a drawdown of _____ ft. after _____ hours of pumping

WELL DATA

Well Depth Casing Diameter (In.) Casing Length (Ft.)
638' 2" 628'

Type of Casing Hole Depth Depth to Static Water Level
PVC 638' 45'

LOG DATA

TYPE OF LOG RUN (Circle One):
Electric, Gamma Ray, Density, Sonic, Neutron, Other (Describe) **No Log Run**

Name of Organization Running Log

TYPE OF COMPLETION: (Circle One or More):
Gravel Packed, Underreamed, Telescoped, **Natural Development**, Open Hole, Other

WELL GROUTED TO A DEPTH OF **20** FEET
Type Grout (circle one): Cement, Bentonite, or Mix

GEOLOGIC DATA (Office Use Only)

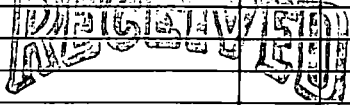
Surface Elev.	Geologic Unit	Unit Thickness	Depth to Top
Subs. SWL	Date	Analysis	Aquifer Test

SCREEN DATA

Diameter - Inches Length - Feet Slot Size - Inches
2" 10' .008

Screen Type Depth to Bottom - Feet
PVC 638'

Driller's Remarks

DESCRIPTION OF FORMATIONS ENCOUNTERED	FROM	TO	FORMATIONS (Continued)	FROM	TO
Top Soil	0	4	 NOV 09 1995 Dept. of Environmental Quality Office of Land & Water Resources		
gravel	4	17			
Changeover clay	12	60			
Med sand	60	140			
Orange clay	140	165			
Blue clay streaked w/ sand	165	395			
Med. Coarse sand	395	511			
Blue clay	511	570			
Coarse sand	570	658			

IF MORE SPACE IS NEEDED, USE BACK

If well telescopes please sketch and show depths.

GROUND LEVEL

			X

SECTION 34

Please indicate well location X.

ADDITIONAL INFORMATION

If more than one screen,
show location of each on sketch.