

COUNTY WELL LOCATED
HARRISON

WELL NUMBER **H 436** CODED

DATE WELL COMPLETED
6-20-98

GW-15320

PERMIT NUMBER
0404

NAME OF DRILLING FIRM
LYMAN WELL CO.

GULFPORT, MS

MISSISSIPPI DEPARTMENT OF ENVIRONMENTAL QUALITY
Office of Land and Water Resources
8/10/04
P. O. Box 10631
Jackson, MS 39289-0631
WATER WELL DRILLERS LOG

NAME & MAILING ADDRESS OF LANDOWNER
Superior Utility

501 9th Ave

Gulfport MS 39603

WELL LOCATION SEC **15** TOWNSHIP **6 N** RANGE **10 E**

DISTANCE **6** Miles **N** of **Biloxi**

OTHER LANDMARK

WELL PURPOSE: Home, Irrigation, Municipal, Industrial, Fish Pond, etc.

PUMP DATA

PUMP TYPE (Circle One):
Submersible, Turbine, Jet, Flowing Well,
Other (Describe)

POWER TYPE (Circle One):
Electric, Tractor, Diesel, Gasoline, Butane,
Other (Describe) H/P **40**

Pump Capacity (GPM) **400** No. of Stages **9 str** Setting Depth **180** FT.

PUMP TEST

Well yielded **600** GPM with
a drawdown of **3'** ft.
after **24** hours of pumping

WELL DATA

Well Depth 730	Casing Diameter (In.) 10"	Casing Length (Ft.) 675
Type of Casing steel	Hole Depth 745	Depth to Static Water Level 129

TYPE OF COMPLETION: (Circle One or More):
Gravel Packed, Underreamed, Telescoped,
Natural Development, Open Hole, Other

WELL GROUTED TO A DEPTH OF **675** FEET
Type Grout (circle one): Cement, Bentonite, or Mix

LOG DATA

TYPE OF LOG RUN (Circle One):
No Log Run, Gamma Ray, Density, Sonic, Neutron,
Other (Describe)

Name of Organization Running Log
state

SCREEN DATA

Diameter - Inches 6"	Length - Feet 50'	Slot Size - Inches .10
Screen Type SS	Depth to Bottom - Feet 730	

GEOLOGIC DATA (Office Use Only)

Surface Elev.	Geologic Unit	Unit Thickness	Depth to Top
Subs. SWL	Date	Analysis	Aquifer Test

Driller's Remarks

Top of Lap Pipe or Reduction in Casing
FEET IF TELESCOPED OR MORE THAN ONE SCREEN: USE BACK PAGE

DESCRIPTION OF FORMATIONS ENCOUNTERED

DESCRIPTION OF FORMATIONS ENCOUNTERED	FROM	TO
RECEIVED FEB 01 1999 Dept. of Environmental Quality Office of Land & Water Resources		


FORMATIONS (Continued)

FORMATIONS (Continued)	FROM	TO
Yellow clay	0	10
white yellow clay	10	120
Blue clay	120	430
sand	430	570
Blue clay	570	675
sand	675	735

IF MORE SPACE IS NEEDED USE BACK

If well telescopes please sketch and show depths.

GROUND LEVEL

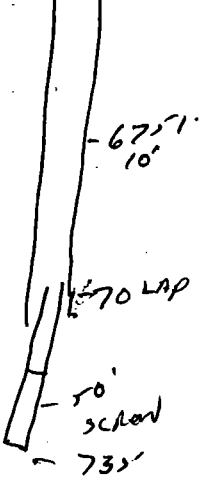

SECTION _____

Please indicate well location X.

ADDITIONAL INFORMATION

Lined area for additional information.

REGISTRATION
NOV 19 1977

WELL INFORMATION TO BE
FORWARDED TO THE STATE

If more than one screen, show location of each on sketch.