

MISSISSIPPI DEPARTMENT OF ENVIRONMENTAL QUALITY

Office of Land and Water Resources

P. O. Box 10631
Jackson, MS 39289-0631
WATER WELL DRILLERS LOG

COLIN WELL LOCATOR
Harrison

WELL NUMBER **H-439** CODED

DATE WELL COMPLETED
12-21-01

PERMIT NUMBER

NAME OF DRILLING FIRM
Conservation Well Service

NAME & MAILING ADDRESS OF LANDOWNER
**Southeastern Properties
Hwy 67 Biloxi, MS.**

Latitude:
Longitude:

WELL LOCATION: SEC **34** TOWNSHIP **6th** RANGE **10th**

DISTANCE **4** Miles DIRECTION **North** of **Biloxi** NEAREST TOWN

OTHER LANDMARK

WELL PURPOSE: Home, Irrigation, Municipal, Industrial, Fish Pond, etc.
Office Bldg

PUMP DATA

PUMP TYPE (Circle One):
 Submersible Turbine, Jet, Flowing Well,
Other (Describe)

POWER TYPE (Circle One):
 Electric Tractor, Diesel, Gasoline, Butane,
Other (Describe) **H/P 3**

DESCRIPTION OF FORMATIONS ENCOUNTERED	FROM	TO
Top Soil	0	2
Orange Clay	2	43
Medium Sand	43	118
Orange and Blue Clay	118	395
Medium and Coarse Sand	395	510
Blue Clay	510	575
Gray Coarse Sand	575	605

WELL DATA

Well Depth 605'	Casing Diameter (In.) 4 1/2"	Casing Length (Ft.) 585'
Type of Casing PVC	Hole Depth 605'	Depth to Static Water Level 50'

TYPE OF COMPLETION: (Circle One or More):
 Gravel Packed, Underreamed, Telescoped,
 Natural Development, Open Hole, Other
(Describe)

WELL GROUTED TO A DEPTH OF **10** FEET
Type Grout (circle one): Cement, (Bentonite), or Mix

SCREEN DATA

Diameter - Inches 2"	Length - Feet 20'	Slot Size - Inches .008
Screen Type PVC	Depth to Bottom - Feet 605'	

REC'D JAN 24 2002

Top of Lap Pipe or Reduction in Casing


FEET IF TELESCOPED OR MORE THAN ONE SCREEN: USE BACK PAGE

I certify that the well was drilled, constructed and completed in accordance with all applicable Requirements of the Mississippi Department of Environmental Quality and/or the Mississippi Department of Health regulations and state laws.

Jack Ridgell, 472
Signature of Licensed Driller and License No.

1/18/02
Date

If well telescopes please sketch and show depths.

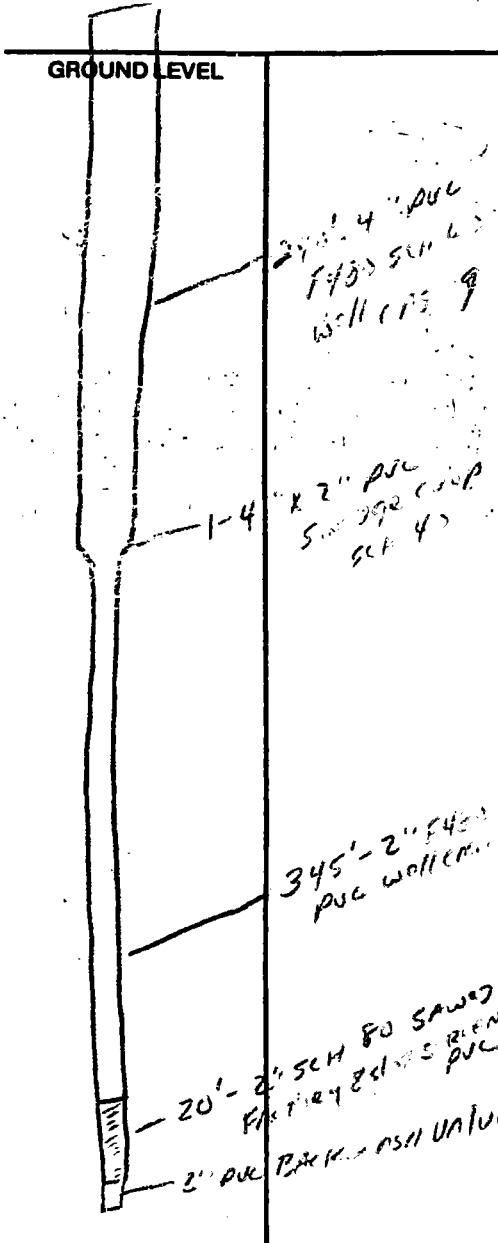

			X

SECTION 34

Please indicate well location X.

Pump Capacity (GPM) <u>35</u>	No. of Stages <u>11</u>	Setting Depth <u>140</u> FT.
PUMP TEST		
Well yielded _____ GPM with		
a drawdown of _____ ft.		
after _____ hours of pumping		

LOG DATA

TYPE OF LOG RUN (Circle One): No Log Run, Electric, Gamma Ray, Density, Sonic, Neutron, Other (Describe) _____

Name of Organization Running Log _____

GEOLOGIC DATA (Office Use Only)

Surface Elev.	Geologic Unit	Unit Thickness	Depth to Top
Subs. SWL	Date	Analysis	Aquifer Test

Driller's Remarks

If more than one screen, show location of each on sketch.