

MISSISSIPPI DEPARTMENT OF ENVIRONMENTAL QUALITY

Office of Land and Water Resources

P. O. Box 10631
Jackson, MS 39289-0631

WATER WELL DRILLERS LOG

COUNTY WELL LOCATED <i>Harrison</i>	
WELL NUMBER <i>H-459</i>	CODED
DATE WELL COMPLETED <i>6-25-03</i>	

PERMIT NUMBER
NAME OF DRILLING FIRM <i>Coastal Drilling & Service Company</i>

NAME & MAILING ADDRESS OF LANDOWNER <i>Chris Boos</i>			
<i>3496 Semple Ct. Saucier, MS</i>			
Latitude:			
Longitude:			
WELL LOCATION	SEC <i>4</i>	TOWNSHIP <i>6</i>	RANGE <i>N 10 E</i>
DISTANCE <i>7</i> Miles	DIRECTION <i>N</i>	NEAREST TOWN <i>Biloxi</i>	
OTHER LANDMARK			
WELL PURPOSE (Home, Irrigation, Municipal, Industrial, Fish Pond, etc.) <i>Home</i>			

PUMP DATA			
PUMP TYPE (Circle One): <input checked="" type="checkbox"/> Submersible <input type="checkbox"/> Turbine <input type="checkbox"/> Jet <input type="checkbox"/> Flowing Well, Other (Describe) _____			
POWER TYPE (Circle One): <input checked="" type="checkbox"/> Electric <input type="checkbox"/> Tractor <input type="checkbox"/> Diesel <input type="checkbox"/> Gasoline <input type="checkbox"/> Butane, Other (Describe) _____ H/P <i>1</i>			

DESCRIPTION OF FORMATIONS ENCOUNTERED	FROM	TO
<i>top soil</i>	<i>1</i>	<i>3</i>
<i>red clay</i>	<i>3</i>	<i>18</i>
<i>sugar sand</i>	<i>18</i>	<i>105</i>
<i>coarse white sand</i>	<i>105</i>	<i>165</i>
<i>blue clay</i>	<i>165</i>	<i>220</i>
<i>fine water sand</i>	<i>220</i>	<i>240</i>
<i>hard blue clay</i>	<i>240</i>	<i>380</i>
<i>fine water sand</i>	<i>380</i>	<i>400</i>
<i>coarse water sand</i>	<i>400</i>	<i>450</i>

WELL DATA		
Well Depth <i>430'</i>	Casing Diameter (In.) <i>4x2</i>	Casing Length (Ft.) <i>430'</i>
Type of Casing <i>PVC</i>	Hole Depth <i>430'</i>	Depth to Static Water Level <i>100'</i>
TYPE OF COMPLETION: (Circle One or More): <input checked="" type="checkbox"/> Gravel Packed <input type="checkbox"/> Underreamed <input type="checkbox"/> Telescoped, <input checked="" type="checkbox"/> Natural Development <input type="checkbox"/> Open Hole <input type="checkbox"/> Other (Describe) _____		
WELL GROUTED TO A DEPTH OF <i>15</i> FEET Type Grout (circle one): Cement, Bentonite, or Mix		

SCREEN DATA		
Diameter - Inches <i>2"</i>	Length - Feet <i>10'</i>	Slot Size - Inches <i>.006</i>
Screen Type <i>PVC</i>	Depth to Bottom - Feet <i>430'</i>	

RECEIVED	
JUL 31 2003	
BY: OLWR	
Top of Lap Pipe or Reduction in Casing	IF TELESCOPED OR MORE THAN ONE SCREEN: USE BACK PAGE
FEET	

I certify that the well was drilled, constructed and completed in accordance with all applicable Requirements of the Mississippi Department of Environmental Quality and/or the Mississippi Department of Health regulations and state laws.

Driff Wilson *0-209*
Signature of Licensed Driller and License No.

7-28-03
Date

Additional Information Required On Back


If well telescopes please sketch and show depths.

GROUND LEVEL

200' 4 inch PVC Casing

220' 2" PVC casing

10 Ft. 2 in PVC screen

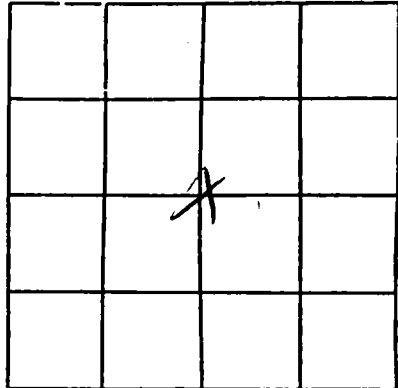

SECTION _____

Please indicate well location X.

Pump Capacity (GPM)	No. of Stages	Setting Depth	
15	14	140	FT.
PUMP TEST			
Well yielded <u>15</u> GPM with			
a drawdown of <u>0</u> ft.			
after <u>2</u> hours of pumping			

LOG DATA

TYPE OF LOG RUN (Circle One): No Log Run, Electric, Gamma Ray, Density, Sonic, Neutron, Other (Describe) _____

Name of Organization Running Log _____

GEOLOGIC DATA (Office Use Only)

Surface Elev.	Geologic Unit	Unit Thickness	Depth to Top
Subs. SWL	Date	Analysis	Aquifer Test

Driller's Remarks

If more than one screen, show location of each on sketch.