

MISSISSIPPI DEPARTMENT OF ENVIRONMENTAL QUALITY

Office of Land and Water Resources

P. O. Box 10631
Jackson, MS 39289-0631

WATER WELL DRILLERS LOG

COUNTY WELL LOCATED <i>Harrison</i>	
WELL NUMBER <i>H-4100</i>	CODED
DATE WELL COMPLETED <i>Aug 21, 03</i>	

PERMIT NUMBER <i>M+M well</i>
NAME OF DRILLING FIRM <i>8827 Boss Hardy</i>
<i>Biloxi Ms.</i>

NAME & MAILING ADDRESS OF LANDOWNER <i>Ray Remoro</i>			
<i>16420 Old Hwy</i>			
<i>Biloxi Ms.</i>			
Latitude:			
Longitude:			
WELL LOCATION	SEC	TOWNSHIP	RANGE
	<i>17</i>	<i>6</i>	<i>9</i>
DISTANCE	DIRECTION	NEAREST TOWN	
<i>5</i> Miles	<i>North</i>	<i>of Diballe</i>	
OTHER LANDMARK <i>1/2 mile Smt Lake</i>			
WELL PURPOSE: Home, Irrigation, Municipal, Industrial, Fish Pond, etc. <i>Home</i>			

PUMP DATA		
PUMP TYPE (Circle One): <input checked="" type="checkbox"/> Submersible <input type="checkbox"/> Turbine <input type="checkbox"/> Jet <input type="checkbox"/> Flowing Well, <input type="checkbox"/> Other (Describe) _____		
POWER TYPE (Circle One): <input checked="" type="checkbox"/> Electric <input type="checkbox"/> Tractor <input type="checkbox"/> Diesel <input type="checkbox"/> Gasoline <input type="checkbox"/> Butane, <input type="checkbox"/> Other (Describe) _____ H/P <i>1</i>		
DESCRIPTION OF FORMATIONS ENCOUNTERED	FROM	TO
<i>Orange clay</i>	<i>0</i>	<i>-20</i>
<i>course sand</i>	<i>20</i>	<i>-80</i>
<i>gray clay</i>	<i>80</i>	<i>-270</i>
<i>poor sand</i>	<i>27</i>	<i>-280</i>
<i>green clay</i>	<i>280</i>	<i>-400</i>
<i>sand</i>	<i>400</i>	<i>-406</i>
<i>gray clay</i>	<i>406</i>	<i>-760</i>
<i>sand</i>	<i>760</i>	<i>-840</i>
RECEIVED		
SEP 02 2003		
BY: OLWR		
Top of Lap Pipe or Reduction in Casing		
FEET	IF TELESCOPED OR MORE THAN ONE SCREEN: USE BACK PAGE	

WELL DATA		
Well Depth <i>840</i>	Casing Diameter (In.) <i>4 1/2</i>	Casing Length (FL) <i>820</i>
Type of Casing <i>PVC</i>	Hole Depth <i>840</i>	Depth to Static Water Level <i>12</i>
TYPE OF COMPLETION: (Circle One or More): <input checked="" type="checkbox"/> Gravel Packed <input type="checkbox"/> Underreamed <input type="checkbox"/> Telescoped, <input checked="" type="checkbox"/> Natural Development <input type="checkbox"/> Open Hole <input type="checkbox"/> Other (Describe) _____		
WELL GROUTED TO A DEPTH OF <i>14</i> FEET		
Type Grout (circle one): Cement, Bentonite, or Mix		

SCREEN DATA		
Diameter - Inches <i>2"</i>	Length - Feet <i>20'</i>	Slot Size - Inches <i>.006</i>
Screen Type <i>PVC</i>	Depth to Bottom - Feet <i>820-840</i>	

I certify that the well was drilled, constructed and completed in accordance with all applicable Requirements of the Mississippi Department of Environmental Quality and/or the Mississippi Department of Health regulations and state laws.


Sh Middle 0563
Signature of Licensed Driller and License No.

Aug 26, 03
Date

Additional Information Required On Back

If well telescopes please sketch and show depths.

GROUND LEVEL

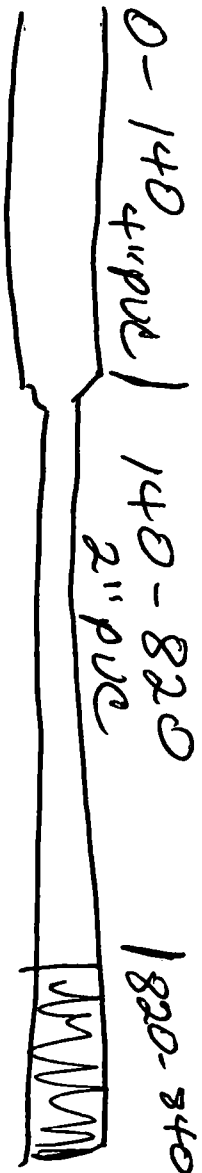

	X		

SECTION 17

Please indicate well location X.

Pump Capacity (GPM) <u>20</u>	No. of Stages <u>9</u>	Setting Depth <u>50</u> FT.
----------------------------------	---------------------------	--------------------------------

PUMP TEST
Well yielded 38 GPM with
a drawdown of _____ ft.
after _____ hours of pumping

LOG DATA

TYPE OF LOG RUN (Circle One): No Log Run.
Electric, Gamma Ray, Density, Sonic, Neutron.
Other (Describe) _____

Name of Organization Running Log _____

GEOLOGIC DATA (Office Use Only)

Surface Elev.	Geologic Unit	Unit Thickness	Depth to Top
Subs. SWL	Date	Analysis	Aquifer Test

Driller's Remarks

If more than one screen, show location of each on sketch.