

MISSISSIPPI DEPARTMENT OF ENVIRONMENTAL QUALITY
Office of Land and Water Resources

P. O. Box 10631
Jackson, MS 39289-0631
WATER WELL DRILLERS LOG

COUNTY WELL LOCATED <i>Harrison</i>	
WELL NUMBER <i>H-4102</i>	CODED
DATE WELL COMPLETED <i>8-26-03</i>	

PERMIT NUMBER
NAME OF DRILLING FIRM <i>Coast Water Well Service</i>

NAME & MAILING ADDRESS OF LANDOWNER <i>Opel Lake Bell Ave</i>			
Latitude:			
Longitude: <i>Biloxi, Ms</i>			
WELL LOCATION	SEC	TOWNSHIP	RANGE
	<i>18</i>	<i>6^N</i>	<i>10^W</i>
DISTANCE	DIRECTION	NEAREST TOWN	
<i>8 1/2</i> Miles	<i>NW</i>	of <i>Biloxi</i>	
OTHER LANDMARK			
WELL PURPOSE: <input checked="" type="radio"/> Home, <input type="radio"/> Irrigation, <input type="radio"/> Municipal, <input type="radio"/> Industrial, <input type="radio"/> Fish Pond, etc.			

PUMP DATA		
PUMP TYPE (Circle One): Submersible, Turbine, <input checked="" type="radio"/> Jet, Flowing Well, Other (Describe) _____		
POWER TYPE (Circle One): <input checked="" type="radio"/> Electric, Tractor, Diesel, Gasoline, Butane, Other (Describe) _____ H/P <i>1</i>		
DESCRIPTION OF FORMATIONS ENCOUNTERED	FROM	TO
<i>Top Soil</i>	<i>0</i>	<i>2</i>
<i>Orange Clay</i>	<i>2</i>	<i>11</i>
<i>Brown Coarse Sand</i>	<i>7</i>	<i>23</i>
<i>Orange + Blue Clay</i>	<i>23</i>	<i>94</i>
<i>Low Medium Sand</i>	<i>94</i>	<i>111</i>
<i>Blue Clay</i>	<i>111</i>	<i>395</i>
<i>Grey Medium Sand</i>	<i>395</i>	<i>420</i>
RECEIVED		
SEP 05 2003		
BY: OLWR		
Top of Lap Pipe or Reduction in Casing		
FEET	IF TELESCOPED OR MORE THAN ONE SCREEN: USE BACK PAGE	

WELL DATA

Well Depth <i>420'</i>	Casing Diameter (in.) <i>2"</i>	Casing Length (FL) <i>405'</i>
Type of Casing <i>PVC</i>	Hole Depth <i>420'</i>	Depth to Static Water Level <i>45'</i>
TYPE OF COMPLETION: (Circle One or More): <input checked="" type="radio"/> Gravel Packed, <input type="radio"/> Underreamed, <input type="radio"/> Telescoped, <input checked="" type="radio"/> Natural Development, <input type="radio"/> Open Hole, <input type="radio"/> Other (Describe) _____		
WELL GROUTED TO A DEPTH OF <i>10</i> FEET Type Grout (circle one): Cement, <input checked="" type="radio"/> Bentonite, or Mix		

SCREEN DATA

Diameter - Inches <i>2"</i>	Length - Feet <i>10'</i>	Slot Size - Inches <i>.006</i>
Screen Type <i>PVC</i>	Depth to Bottom - Feet <i>420'</i>	

I certify that the well was drilled, constructed and completed in accordance with all applicable Requirements of the Mississippi Department of Environmental Quality and/or the Mississippi Department of Health regulations and state laws.


Jack Reddell 472
Signature of Licensed Driller and License No.

9/3/03
Date

Additional Information Required On Back

If well telescopes please sketch and show depths.

GROUND LEVEL

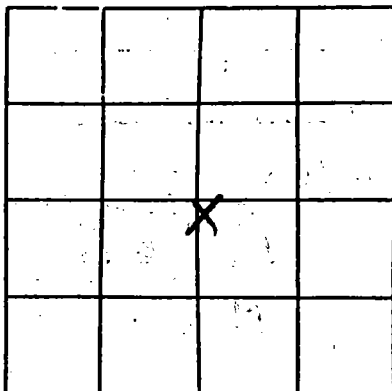

SECTION 18

Please indicate well location X.

Pump Capacity (GPM) <u>9</u>	No. of Stages <u>2</u>	Setting Depth <u> </u> FT.
PUMP TEST		
Well yielded <u> </u> GPM with		
a drawdown of <u> </u> ft.		
after <u> </u> hours of pumping		

LOG DATA

TYPE OF LOG RUN (Circle One):
 Electric, Gamma Ray, Density, No Log Run, Sonic, Neutron,
 Other (Describe)

Name of Organization Running Log

GEOLOGIC DATA (Office Use Only)

Surface Elev.	Geologic Unit	Unit Thickness	Depth to Top
Subs. SWL	Date	Analysis	Aquifer Test

Driller's Remarks

If more than one screen, show location of each on sketch.