

MISSISSIPPI DEPARTMENT OF ENVIRONMENTAL QUALITY

Office of Land and Water Resources

P. O. Box 10631
Jackson, MS 39289-0631

WATER WELL DRILLERS LOG

COUNTY WELL LOCATED Harrison	
WELL NUMBER A-484	CODED
DATE WELL COMPLETED 2-5-04	

PERMIT NUMBER
NAME OF DRILLING FIRM Coastal Water Well Service

NAME & MAILING ADDRESS OF LANDOWNER C.N. Williams			
S. Carrbridge Rd.			
Latitude:			
Longitude: Biloxi, MS			
WELL LOCATION, SEC	TOWNSHIP	RANGE	
4	6	10	
DISTANCE	DIRECTION	NEAREST TOWN	
7 Miles	NORTH of	Biloxi	
OTHER LANDMARK			
WELL PURPOSE: Home, Irrigation, Municipal, Industrial, Fish Pond, etc.			

PUMP DATA			
PUMP TYPE (Circle One): <input checked="" type="radio"/> Submersible, <input type="radio"/> Turbine, <input type="radio"/> Jet, <input type="radio"/> Flowing Well, Other (Describe) _____			
POWER TYPE (Circle One): <input checked="" type="radio"/> Electric, <input type="radio"/> Tractor, <input type="radio"/> Diesel, <input type="radio"/> Gasoline, <input type="radio"/> Butane, Other (Describe) _____ H/P 1			

DESCRIPTION OF FORMATIONS ENCOUNTERED	FROM	TO
Top Soil	0	2
Orange Clay	2	18
Brown Coarse Sand	18	50
Orange + White Clay	50	60
Coarse Sand	60	91
Orange + Blue Clay w/ sand	91	405
Grey Coarse Sand	405	483

WELL DATA		
Well Depth 483'	Casing Diameter (In.) 4" x 2"	Casing Length (Ft.) 483
Type of Casing PVC	Hole Depth 483'	Depth to Static Water Level 130'
TYPE OF COMPLETION: (Circle One or More): <input checked="" type="checkbox"/> Gravel Packed, <input type="checkbox"/> Underrreamed, <input type="checkbox"/> Telescoped, <input checked="" type="checkbox"/> Natural Development, <input type="checkbox"/> Open Hole, <input type="checkbox"/> Other (Describe) _____		
WELL GROUTED TO A DEPTH OF 10 FEET Type Grout (circle one): Cement, <input checked="" type="checkbox"/> Bentonite, or Mix		

SCREEN DATA		
Diameter - Inches 2"	Length - Feet 20'	Slot Size - Inches 0.008
Screen Type PVC	Depth to Bottom - Feet 483'	

RECEIVED	
FEB 13 2004	
BY: OLWR	
Top of Lap Pipe or Reduction in Casing	
FEET	IF TELESCOPED OR MORE THAN ONE SCREEN: USE BACK PAGE

I certify that the well was drilled, constructed and completed in accordance with all applicable Requirements of the Mississippi Department of Environmental Quality and/or the Mississippi Department of Health regulations and state laws.


Jack Reddell 472
Signature of Licensed Driller and License No.

2/9/04
Date

Additional Information Required On Back

If well telescopes please sketch and show depths.

GROUND LEVEL

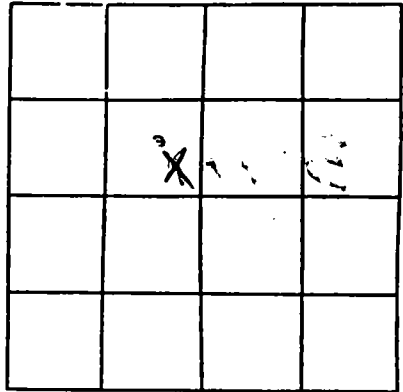

SECTION 4

Please indicate well location X.

Pump Capacity (GPM)	No. of Stages	Setting Depth
<u>10</u>	<u>10</u>	<u>200</u> FT.

PUMP TEST

Well yielded _____ GPM with
 a drawdown of _____ ft.
 after _____ hours of pumping

LOG DATA

TYPE OF LOG RUN (Circle One):
 Electric, Gamma Ray, Density, No Log Run, Sonic, Neutron,
 Other (Describe) _____

Name of Organization Running Log

GEOLOGIC DATA (Office Use Only)

Surface Elev.	Geologic Unit	Unit Thickness	Depth to Top
Subs. SWL	Date	Analysis	Aquifer Test

Driller's Remarks

If more than one screen,
 show location of each on sketch.