

MISSISSIPPI DEPARTMENT OF NATURAL RESOURCES

Bureau of Land and Water Resources

Southport Mall

P.O. Box 10631

Jackson, Mississippi 39209

WATER WELL DRILLERS LOG

Harrison
H-507

Sept. 23 1982 Duncan Well Drilling Harrison
date well completed firm name county well located

LANDOWNER: Richard Ball
P.O. 2 Box 169-M
Laurens, Ms.
(mailing address)

description of formations encountered	from	to
<u>Mud Sand</u>	<u>0</u>	<u>30</u>
<u>Sand, Mud, Clay mixed</u>	<u>30</u>	<u>60</u>
<u>fine Sand</u>	<u>60</u>	<u>85</u>
<u>Course Sand</u>	<u>85</u>	<u>120</u>

WELL LOCATION:
sec. 7 T. 6 N. R. 10 E.
3 miles NE of Lyman
(distance) (direction) (nearest town)

WELL PURPOSE: Home
(home, irrigation, municipal, industrial)

WELL COMPLETION DATA:
(1) diameter (inches) 2"
(2) total depth (feet) 120 ft
(3) static water level (feet) 20' below above top of ground.
(4) casing PVC, 115' (material) (depth)
(size) if telescope see back.
(5) screen 10', 115 (length) (depth to top)
(size) (material) 2, PVC
(6) pump 1 (HP) 8 (yield gpm)
(type power) electric
(7) electric log _____ (yes or no)

(organization running log) _____
(8) how well bottom plugged Sand
Mark

DRILLERS REMARKS: _____


DEPT. OF NATURAL RESOURCES
BUREAU OF LAND & WATER RESOURCES

JAN 21 1983

RECEIVED

If well telescopes please sketch and show depths.

GROUND LEVEL

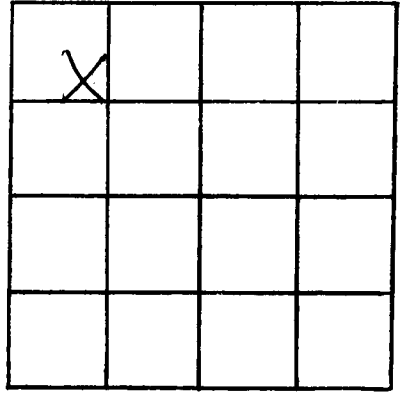

SECTION 7

Please indicate well location X.

ADDITIONAL INFORMATION

If more than one screen, show locations of each on sketch.