Sta	te Well Report	For Office Use Only:
County: Harrison	Part 1	
Mississippi Dep	bartment of Environmental Quality Land and Water Resources	Aquifer:
an Constitutoria voll Sor	P.O. Box 10631	Well #: <u>H-576</u>
Jac	kson, MS 39289-0631	L. S. Elevation:
Date drilling completed: <u>3. 35-08</u>	(601) 961-5210 601) 354-6938 (fax)	E-log #:
	her the driller in detail and filed a	with the Department within
State Law requires that this report be prepared 30 days of completion of drilling of the well.		
Well Owner Information		ll Location
Owner Name_Dorothy Clark	Latitude: <u>30 ° 28 ' 4/</u>	2" Longitude: <u>C88° 57' 700</u> " <b>42</b>
Mailing Address:	Method of Lat/Long (circle of	one): Conventional Survey,
13084 Husley Kol.		d GPS, Survey-grade GPS
BILOXI MS 3953 City State Zip Code	SE 1/2 Siv 1/2 Sec_ 3 5	Twn T65 Rng R/ow
Telephone No. ( <u>228)</u> <u>392 - 56666</u>	Distance Direction Miles Enser	Nearest Town of WoolmAnker
	Well Data	
Purpose of Well (circle one Home Industrial Public S	upply Irrigation Fish Culture	Other:
Date well drilling started: <u>3-24-08</u>	Date well drilling completed: 3	-25-08
If flowing, method of flow regulation: Valve $N/A$	Other (describe)	
Static Water Level: 45 feet above or below (circ	le one) land surface Date measured:	3-25-08
Method of Measurement (circle one) steel tape elect	tric tape air line other:	
Hole depth: $415'$ Well depth: $415'$	Well grouted to a depth of	<u>/()</u> feet
Type of grout (circle one): Cement Bentonite	Mix	
Casing length: <u>405</u> feet Casing diameter:	inches Type of casing:	PVC
Screen length: 10 feet Screen diameter:	inches Type of screen:	PVC
Screen slot size: <u>• OCY</u> inches Setting depth:	From <u>405</u> feet to	<u>415</u> feet
Type of completion (circle all applicable): Gravel packed	Underreamed Telescoped Oper	n hole Natural Development
Other (describe)	:	
Top of lap pipe or reduction in casing: $N/A$ fe	et. If telescoped or more than one scr	reen, describe on back of page
Logs run (circle all applicable); No log run Electric Gam	ma Ray Density Sonic Neutron	Other:
Name of organization running log(s):		
I certify that the well was drilled, constructed, and comple Department of Environmental Quality and/or the Mississ		• • •
		ALA.
Jack Klappell U-412	the	apples
Print Name of Water Well Contractor and License No.	Signature of	f Water Well Contractor EIVED
		400 0 0 0 0 0 0 0 0 0 0 0 0 0 0 0 0 0 0

.•

• • •

APR 1 0 2008 2V- OI WR


·

H-576

If well telescopes please sketch below and show depths.

Ground Level	Description of Formations Encountered	From	
	Grange and Blue Closes gray medum sand	400	400 414

If more than one screen, show location of each on sketch

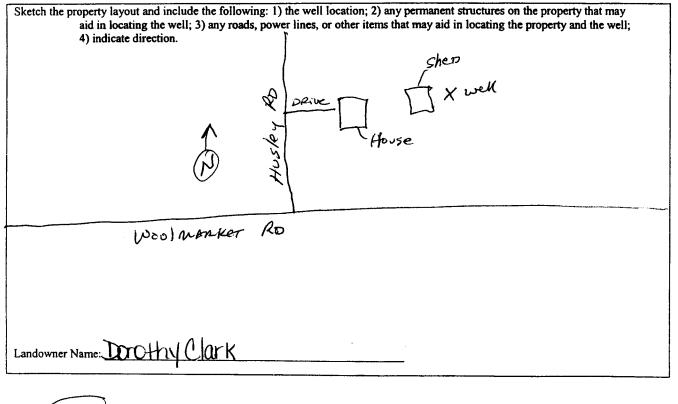

Signature of Water Well Contractor

APR 1 0 2008 BY: OLWR

STATE W	ELL REPORT
County: <u>HATTISON</u> Permit #: Office of Land Driller: <u>MSTWATER WISS</u> Driller: <u>CASTWATER WISS</u> Driller: <u>CASTWATER WISS</u> Driller: <u>CASTWATER WISS</u> <u>County: HATTISON</u> Pump Installer Mississippi Departm Office of Land P.O Jackson, (60)	Part 2 For Office Use Only:   r's Completion Report Aquifer:   ent of Environmental Quality Aquifer:   and Water Resources Weil #:
This report should be prepared by the pump installer in de	tail and filed with the Department within 30 days of the
installation of pump. Well Owner Information	Well Location
Owner Name: DOrOthy Clark	Latitude: 30 28' 412" Longitude: 088' 57' 70
Mailing Address: 13084 HUSLEY Rd.	Method of Lat/Long (circle one): Conventional Survey,
	USGS quad, Hand-held GPS, Survey-grade GPS
Biloxi MS 39532	SE 1/4 501/4 Sec 35 Twn TGS Rng RIOW
City State Zip Code	Distance Direction Nearest Town
Telephone No. <u>228</u> ) <u>392</u> - 5666	/ Miles Exect of Woolmon 1000
Ритр Туре	Power Type
Circle one	Circle one
Air Lift (Jet) Submersible	Diesel Engine Gasoline Engine Natural Gas
Bucket Piston Turbine	Electric Motor Hand Tractor PTO
Centrifugal Rotary Flowing Well	Windmill Other (specify):
Other (specify):	Horse Power Rating of Motor:
Date Pump Installed: 3-35-08	Setting Depth: 60FT. Droppipe feet
Rated Pump Capacity:Gallons Per Minute	Number of Stages:
Pump Test Data	Method of Measuring Water Level Circle one
Date Well Tested: 3-25-08	
Static Water Level (A):Feet Below Land Surface	
Pumping Water Level (B): <u>NA</u> Feet Below Land Surface	Other (specify):
Drawdown [(B) – (A)]: $NA$ Feet Below Land Surface	For flowing well, measured shut in head: $\frac{N/A}{A}$ feet
Test Pumping Rate: Gallons Per Minute	Well yielded GPM with a drawdown of
Duration of Pump Test (minimum 4 hours):hours	N A feet after $N A$ hours of pumping
I HEREBY CERTIFY that the above statements are true to the best of $T_{O} = k D \left[ \frac{1}{2} - \frac{1}{2} + \frac{1}{2} \right]$	of my knowledge. RECEN
Print Name of Pump Installer and License No. (if applicable)	Signature of Pump Installer APR + 0
	BY: OL

. • •