

State Well Report

Part 1

Mississippi Department of Environmental Quality
Office of Land and Water Resources
P.O. Box 10631
Jackson, MS 39289-0631
(601) 961-5210
(601) 354-6938 (fax)

For Office Use Only:

Aquifer: H 588
Well #: _____
L. S. Elevation: _____
E-log #: _____

County: Harrison
Permit #: _____
Driller: Coast Water Well Serv.
Date drilling completed: 2-11-10

State Law requires that this report be prepared by the driller in detail and filed with the Department within 30 days of completion of drilling of the well.

Well Owner Information	Well Location
Owner Name: <u>Patrick Moore / ^{Andrea} Ulstreen</u>	Latitude: <u>30° 30' 818"</u> Longitude: <u>088° 59' 184"</u>
Mailing Address: <u>Old Woolmarket Rd.</u> <u>HANNAH LANE</u>	Method of Lat/Long (circle one): Conventional Survey, ¹¹
<u>Biloxi, MS 39532</u>	USGS quad, <u>(Hand-held GPS)</u> Survey-grade GPS
City State Zip Code	<u>NG 1/4 NE 1/4 Sec 21</u> T6S R10W
Telephone No. <u>601-327-5166</u>	Distance Direction Nearest Town <u>4</u> Miles <u>North</u> of <u>Biloxi</u>

Well Data

Purpose of Well (circle one) Home Industrial Public Supply Irrigation Fish Culture Other: _____

Date well drilling started: 2-8-10 Date well drilling completed: 2-11-10

If flowing, method of flow regulation: Valve N/A Other (describe) _____

Static Water Level: 95 feet above or below (circle one) land surface Date measured: 2-11-10

Method of Measurement (circle one) steel tape electric tape air line other: _____

Hole depth: 690 FT Well depth: 690 FT Well grouted to a depth of 10 feet

Type of grout (circle one): Cement Bentonite Mix

Casing length: 500' x 4" 440' x 2" feet Casing diameter: 4x2 inches Type of casing: PVC

Screen length: 20 feet Screen diameter: 2 inches Type of screen: PVC

Screen slot size: .006 inches Setting depth: From 670 feet to 690 feet

Type of completion (circle all applicable): Gravel packed Underreamed Telescoped Open hole Natural Development

Other (describe): _____

Top of lap pipe or reduction in casing: N/A feet. If telescoped or more than one screen, describe on back of page

Logs run (circle all applicable): No log run Electric Gamma Ray Density Sonic Neutron Other: _____

Name of organization running log(s): N/A

I certify that the well was drilled, constructed, and completed in accordance with all applicable requirements of the Mississippi Department of Environmental Quality and/or the Mississippi Department of Health regulations and state laws.

Jack Ridgdell 0-472
Print Name of Water Well Contractor and License No.

Jack Ridgdell
Signature of Water Well Contractor

RECEIVED

FEB 23 2010

BY: OLWR

H 588


If well telescopes please sketch below and show depths.

Ground Level

Description of Formations Encountered	From	To
TOPSOIL	0	2
Orange Clay w/streaks of Sand	2	100
orange coarse sand	100	135
Blue Clay	135	400
Gray coarse sand	400	500
Blue clay	500	655
Gray coarse sand	655	690

If more than one screen, show location of each on sketch

Sketch the property layout and include the following: 1) the well location; 2) any permanent structures on the property that may aid in locating the well; 3) any roads, power lines, or other items that may aid in locating the property and the well; 4) indicate direction.

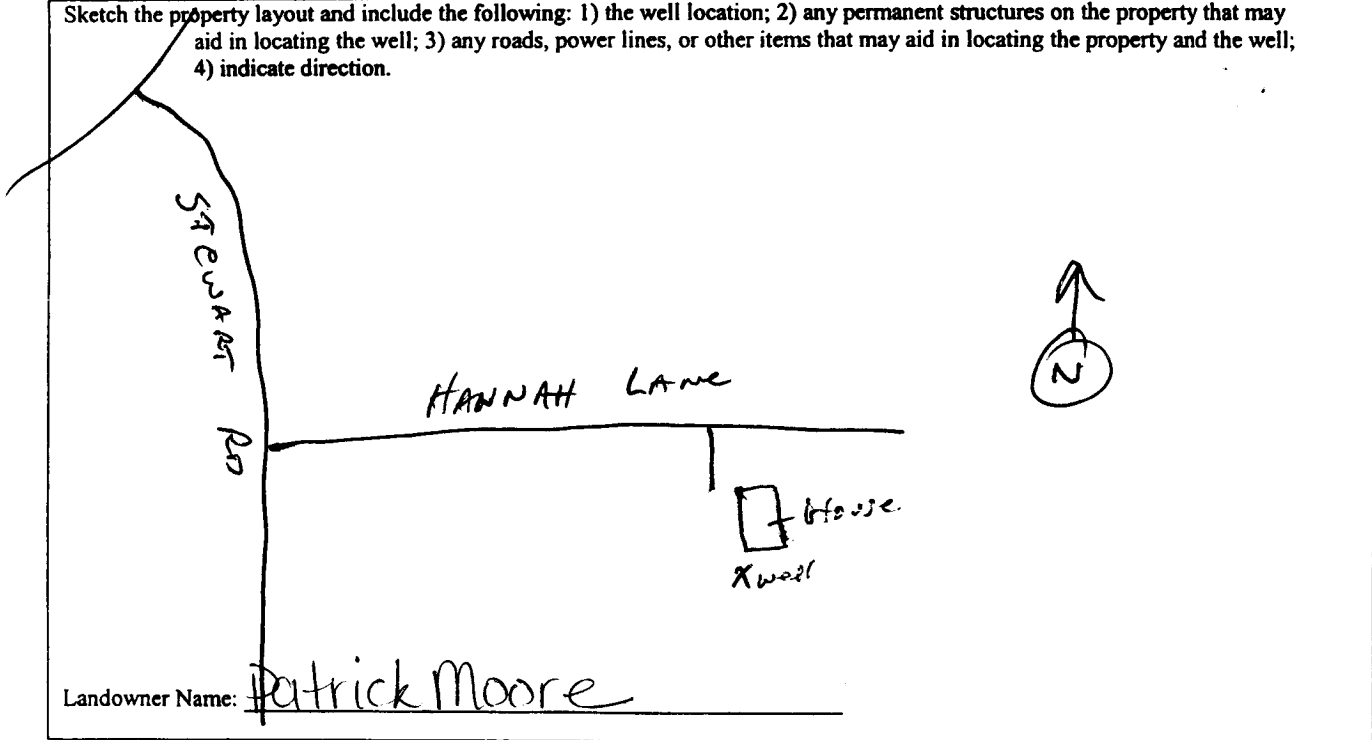

Jan Rydell
Signature of Water Well Contractor

RECEIVED
FEB 23 2010
BY: OLWR

STATE WELL REPORT

Part 2

Pump Installer's Completion Report
 Mississippi Department of Environmental Quality
 Office of Land and Water Resources
 P.O. Box 10631
 Jackson, MS 39289-0631
 (601) 961-5210
 (601) 354-6938 (fax)

For Office Use Only:

Aquifer: H 588
 Well #: _____
 Elevation: _____

County: Harrison
 Permit #: _____
 Driller: Coast Water Well Serv
 Date completed: 2-11-10

This report should be prepared by the pump installer in detail and filed with the Department within 30 days of the installation of pump.

Well Owner Information	Well Location
Owner Name: <u>Patrick Moore / Andrea Wstern</u>	Latitude: <u>30° 30' 818"</u> Longitude: <u>088° 59' 184"</u>
Mailing Address: <u>Hannah Lane</u>	Method of Lat/Long (circle one): Conventional Survey, USGS quad, <u>Hand-held GPS</u> , Survey-grade GPS
<u>Biloxi, Ms 39532</u> City State Zip Code	<u>NE 1/4 NE 1/4 Sec 21 Twn T6S Rng R1CW</u>
Telephone No. <u>(228) 327-5166</u>	Distance Direction Nearest Town <u>4 Miles NORTH of Biloxi</u>

Pump Type Circle one	Power Type Circle one
Air Lift Jet <u>Submersible</u>	Diesel Engine Gasoline Engine Natural Gas
Bucket Piston Turbine	<u>Electric Motor</u> Hand Tractor PTO
Centrifugal Rotary Flowing Well	Windmill Other (specify): _____
Other (specify): _____	Horse Power Rating of Motor: <u>1 HP</u>
Date Pump Installed: <u>2/15/10</u>	Setting Depth: <u>160 FT. Droppipe</u> feet
Rated Pump Capacity: <u>10</u> Gallons Per Minute	Number of Stages: <u>15</u>

Pump Test Data	Method of Measuring Water Level Circle one
Date Well Tested: <u>2/15/10</u>	<u>Air Line</u> Electric Measuring Line Steel Tape
Static Water Level (A): <u>95</u> Feet Below Land Surface	Other (specify): _____
Pumping Water Level (B): <u>N/A</u> Feet Below Land Surface	For flowing well, measured shut in head: <u>N/A</u> feet
Drawdown [(B) - (A)]: <u>N/A</u> Feet Below Land Surface	Well yielded <u>50</u> GPM with a drawdown of
Test Pumping Rate: <u>12</u> Gallons Per Minute	<u>N/A</u> feet after <u>N/A</u> hours of pumping
Duration of Pump Test (minimum 4 hours): <u>5</u> hours	

I HEREBY CERTIFY that the above statements are true to the best of my knowledge.

Jack Ridgdell 0-472 Print Name of Pump Installer and License No. (if applicable) Jack Ridgdell Signature of Pump Installer

RECEIVED
 FEB 23 2010
 BY: OLWR