	State W	ell Report			
County Harrison		Part 1	For Office Use Only:		
		nt of Environmental Quality	Aquifer: <u>H 591</u>		
Permit #:		Office of Land and Water Resources P.O. Box 10631			
Date drilling completed: 8/23/10	-	AS 39289-0631	L. S. Elevation:		
Date drilling completed: 010010) 961-5210 54-6938 (fax)	E-log #:		
State Law requires that this rep	ort be prepared by the	driller in detail and filed w	ith the Department with		
30 days of completion of drilling Well Owner Informa	g of the well.	Wel	Location		
Owner Name Kevin Brouss		Latitude: 30° 31 , 3480 Longitude: 08° 55 , 4			
Mailing Address: 5357 TUXA CHANIE DR.		Method of Lat/Long (circle one): Conventional Survey,			
		USGS quad, Hand-held GPS, Survey-grade GPS			
Biloxi, MS.	<u>39532</u> ite Zip Code	SE 1/2 NW 1/2 Sec 18 Twn T65 Rng R9W			
City , Sta Telephone No. (208) 282 - 342		Distance Direction 3/2-Miles No 1974	Nearest Town of Brank?		
	Weil		····		
Purpose of Well (circle one Home Ind		Irrigation Fish Culture	Other:		
Date well drilling started: 8/23		0	1 1		
	.1	,			
If flowing, method of flow regulation: Val			1 .		
Static Water Level: <u>50</u> feet ab	pove or below (circle one)	land surface Date measured:	<u> </u>		
	teel tape electric tape				
Hole depth: <u>357 FT.</u> Well dep	pth: <u>357 F1.</u>	Well grouted to a depth of	<u> </u>		
Type of grout (circle one): Cement	Bentonite Mix		_		
Casing length: <u>347</u> feet Casin	ng diameter:	inches Type of casing:	PVC		
Screen length: 10 feet Screen diameter: 2 inches Type of screen: PVC					
Screen slot size:	Setting depth: From	<u>347</u> feet to <u>3</u>	57feet		
Type of completion (circle all applicable):	Gravel packed Under	reamed Telescoped Open	hole Natural Developme		
	Other (describe):				
Top of lap pipe or reduction in casing		lescoped or more than one scre			
Logs run (circle all applicable) No log run					
Name of organization running log(s):	MA				
I certify that the well was drilled, constr Department of Environmental Quality a			•		
	uwoi uic mississippi Del	partment of Health regulations	and state laws.		
			111		

.


If well telescopes please sketch below and show depths.

Ground Level

.

	Description of Formations Encountered	From	To
 	TOPSOIL		3
	Orange Clay	12	1 <u>j</u>
	While Coarse Sand	130	277
	Blue Clay	240	244
	Gray Medium Sand	1240	pp4
			<u> </u>
			╂───┤
		+	
		+	<u> </u>
		1	
			
			
		_	
I			

If more than one screen, show location of each on sketch

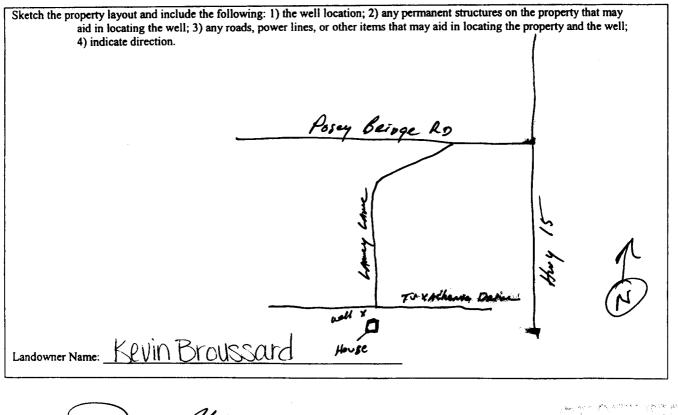

Signature of Water Well Contractor

an main you sh

H591

	STATE WI	ELL REPORT	l	
County: <u>Harrison</u> Permit #: Driller <u>CalStWater Well</u> SRV. Date completed: <u>8/23/10</u>	Part 2 Pump Installer's Completion Report Mississippi Department of Environmental Quality Office of Land and Water Resources P.O. Box 10631 Jackson, MS 39289-0631 (601) 961-5210 (601) 354-6938 (fax)		For Office Use Only: Aquifer: Well #: Elevation:	
This report should be prepared by th	i ne pump installer in deta	il and filed with the Departn	nent within 30 days of the	
installation of pump. Well Owner Informat Owner Name: Kevin Brouss Mailing Address: 5357 Tuxac Biloxi, Ms_3 City State Telephone No. (208) 282 - 3428	Sard Chanie DR, 19532 Zip Code	Latitude: <u>30°31′34.8</u> Method of Lat/Long (circle o USGS quad, (Han	nd-held GPS, Survey-grade GPS 18 Twn T65 Rng & 9 W Nearest Town	
Pump Type Circle one	, <u>,,,,,,,,,,,,,,,,,,,,,,,,,,,,,,,,,,,,</u>		ower Type Circle one	
Air Lift (Jet)	Submersible		ine Engine Natural Gas	
Bucket Piston Centrifugal Rotary	Turbine C	Electric Motor Hand Windmill Other	(specify):	
Other (specify): Date Pump Installed: 8 34 10 Rated Pump Capacity: 7.5	Gallons Per Minute	Horse Power Rating of Moto Setting Depth: <u> HHP</u> Number of Stages: <u>80 F7</u>		
11/0	Below Land Surface		easuring Water Level Circle one asuring Line Steel Tape	
Drawdown [(B) – (A)]: NA Feet	Below Land Surface Gallons Per Minute	For flowing well, measured shut in head: N/A feet Well yielded 24 GPM with a drawdown of N/A feet after N/A hours of pumping		
	ents are true to the best of	feet after	N/A hours of pumping	

•