
State W	'ell Report				
	art 1 For Office Use Only:				
Mississippi Departmen	t of Environmental Quality Aquifer:				
	and Water Resources Well #:				
	IS 39289-0631 L. S. Elevation:				
Date drilling completed: 9/12/11 (601)	961-5210 E-log #:				
State Law requires that this report be prepared by the driller in detail and filed with the Department within 30 days of completion of drilling of the well.					
Well Owner Information	Well Location				
Owner Name Ellioff Hombs	Latitude: 30. 30. 48.94" Longitude 088 . 54 . 56.34				
Mailing Address: <u>P.C. BOX 7299</u>	Method of Lat/Long (circle one): Conventional Survey,				
	USGS quad, Hand-held GPS, Survey-grade GPS				
D'Iberville Ms 39540	NW 1/4 NW 1/4 Sec 20 Twn 65 Rng R9W				
City State Zip Code Telephone No. <u>268</u> 257-9914	Distance Direction Nearest Town <u>51/2</u> Miles <u>NOATH</u> of <u>D'Ibenville</u>				
Weil Data					
Purpose of Well (circle one) Home) Industrial Public Supply Irrigation Fish Culture Other:					
Date well drilling started: 9/12/11 Date well drilling completed: 9/12/11					
If flowing, method of flow regulation: Valve <u>VA</u> Other (describe)					
Static Water Level: <u>50</u> feet above or below (kitcle one) land surface Date measured: <u>9/12///</u>					
Method of Measurement (circle one) steel tape electric tape air line other:					
Hole depth: 335FT. Well depth: 335FT. Well grouted to a depth of 10 feet					
Type of grout (circle one): Cement Bentonite Mix					
Casing length: <u>326</u> feet Casing diameter: <u></u>					
Screen length: 10 feet Screen diameter: 2 inches Type of screen: PVC					
Screen slot size:					
Type of completion (circle all applicable): Gravel packed Underreamed Telescoped Open hole Natural Development					
Other (describe):					
Top of lap pipe or reduction in casing: feet. If telescoped or more than one screen, describe on back of page					
Logs run (circle all applicable): No log run Electric Gamma Ray Density Sonic Neutron Other:					
Name of organization running log(s): N/A					
I certify that the well was drilled, constructed, and completed in accordance with all applicable requirements of the Mississippi Department of Environmental Quality and/or the Mississippi Department of Health manlations and state large					
Department of Environmental Quality and/or the Mississippi Department of Health regulations and state laws.					
Jack Kidgdell 0-472-	- higher				
Print Name of Water Well Contractor and License No.	Signature of Water Well Contractor				

• 7

If well telescopes please sketch below and show depths.

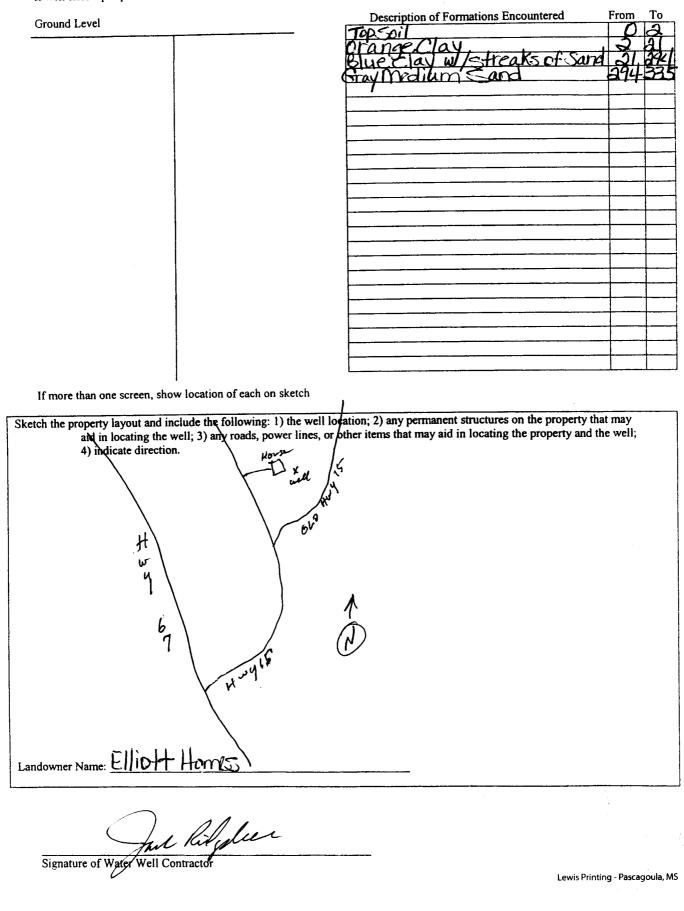

STATE WELL REPORT				
County: Harrison Permit #: Driller: COOF WATER WELLSKV Date completed: 9/12/11	Part 2 Pump Installer's Completion Report Mississippi Department of Environmental Quality Office of Land and Water Resources P.O. Box 10631 Jackson, MS 39289-0631 (601) 961-5210 (601) 354-6938 (fax)		For Office Aquifer: Well #:+	599
This report should be prepared by the pump installer in detail and filed with the Department within 30 days of the				
installation of pump. Well Owner Informat	ion		ell Location	
Owner Name: EllioH HOMBS		Latitude: 2030'48.84		54'50.24
Mailing Address: P.O.BOX 7a	Method of Lat/Long (circle		one): Conventional Survey, 50	
D'Iberville. City State	Ms 37540 Zip Code	USGS quad, $4a$ <u>NW</u> $\frac{1}{4}$ <u>NW</u> $\frac{1}{4}$ Sec <u>C</u> Distance Direction <u>5</u> $\frac{1}{2}$ Miles <u>NO + 1</u>	Nearest Town	Rng RTW
Pump Type		1	ower Type	
Circle one			Circle one	
Air Lift Jet	Submersible		line Engine	Natural Gas
Bucket Piston	Turbine	Electric Motor Hand	3	Tractor PTO
Centrifugal Rotary	Flowing Well	Windmill Othe	r (specify):	
Other (specify):		Horse Power Rating of Motor:		
Date Pump Installed:		Setting Depth: 70FT.	Drop Pipe fe	et
Rated Pump Capacity: 8	Gallons Per Minute	Number of Stages:	2	
	Below Land Surface		-	vel Steel Tape
Drawdown [(B) – (A)]: $\frac{N/A}{A}$ Feet	Below Land Surface	For flowing well, measured	shut in head:	Afeet
Test Pumping Rate:	Gallons Per Minute	Well yielded 20	GPM with a dra	wdown of
Duration of Pump Test (minimum 4 hours):	<u> </u>	NA feet after	NA hour	s of pumping
I HEREBY CERTIFY that the above statem Jack Ridgdk1 0 472 Print Name of Pump Installer and License N		f my knowledge. Signafure of Pump	Installer	BECEWED
		\mathcal{V}		
				001 1 2 2011
				BY: OLAF