

# State Well Report

## Part 1

Mississippi Department of Environmental Quality  
Office of Land and Water Resources  
P.O. Box 10631  
Jackson, MS 39289-0631  
(601) 961-5210  
(601) 354-6938 (fax)

### For Office Use Only:

Aquifer: \_\_\_\_\_  
Well #: 116-00  
L. S. Elevation: \_\_\_\_\_  
E-log #: \_\_\_\_\_

County: HARRISON  
Permit #: \_\_\_\_\_  
Driller: Coast Water Wells SA.  
Date drilling completed: 9/29/11

State Law requires that this report be prepared by the driller in detail and filed with the Department within 30 days of completion of drilling of the well.

Well Owner Information	Well Location
Owner Name: <u>Dean Fletcher</u>	Latitude: <u>30.304170</u> Longitude: <u>088.573660</u>
Mailing Address: <u>15385 Karen Rd.</u>	Method of Lat/Long (circle one): Conventional Survey, USGS quad, <u>Hand-held GPS</u> , Survey-grade GPS
<u>Biloxi, MS 39532</u>	<u>NE</u> 1/4 <u>40</u> 1/4 Sec <u>23</u> Twn <u>T65</u> Rng <u>R10W</u>
City State Zip Code	Distance <u>6</u> Miles Direction <u>NNW</u> of Nearest Town <u>D'Ibeaville</u>
Telephone No. <u>228 861-2430</u>	

### Well Data

Purpose of Well (circle one) Home Industrial Public Supply Irrigation Fish Culture Other: \_\_\_\_\_

Date well drilling started: 9/26/11 Date well drilling completed: 9/29/11

If flowing, method of flow regulation: Valve N/A Other (describe) \_\_\_\_\_

Static Water Level: 100 feet above or below (circle one) land surface Date measured: 9/29/11

Method of Measurement (circle one) steel tape electric tape air line other: \_\_\_\_\_

Hole depth: 700 FT Well depth: 700 FT. Well grouted to a depth of 10 feet

Type of grout (circle one): Cement Bentonite Mix

Casing length: 260' x 4" PVC feet Casing diameter: 4" x 2" inches Type of casing: PVC

Screen length: 20 feet Screen diameter: 2 inches Type of screen: PVC

Screen slot size: .006 inches Setting depth: From 680 feet to 700 feet

Type of completion (circle all applicable): Gravel packed Underreamed Telescoped Open hole Natural Development

Other (describe): \_\_\_\_\_

Top of lap pipe or reduction in casing: N/A feet. If telescoped or more than one screen, describe on back of page

Logs run (circle all applicable): No log run Electric Gamma Ray Density Sonic Neutron Other: \_\_\_\_\_

Name of organization running log(s): N/A


I certify that the well was drilled, constructed, and completed in accordance with all applicable requirements of the Mississippi Department of Environmental Quality and/or the Mississippi Department of Health regulations and state laws.

Jack Ridgell 0472  
Print Name of Water Well Contractor and License No.

Jack Ridgell  
Signature of Water Well Contractor

RECEIVED  
OCT 12 2011


If well telescopes please sketch below and show depths.

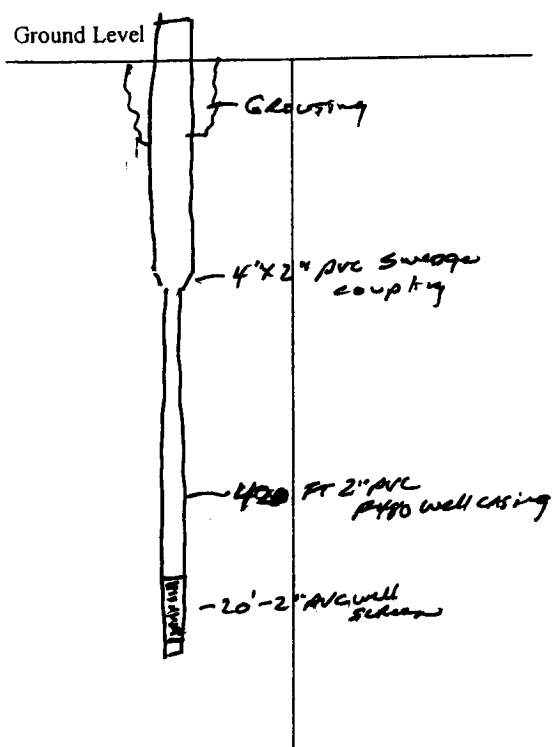

Description of Formations Encountered	From	To
TOP SOIL	0	2
Orange clay w/ streaks of sand	2	30
Blue clay	30	130
Brown coarse sand	130	140
Blue clay w/ streaks of sand	140	656
gray medium to coarse sand	656	700

If more than one screen, show location of each on sketch

Sketch the property layout and include the following: 1) the well location; 2) any permanent structures on the property that may aid in locating the well; 3) any roads, power lines, or other items that may aid in locating the property and the well; 4) indicate direction.

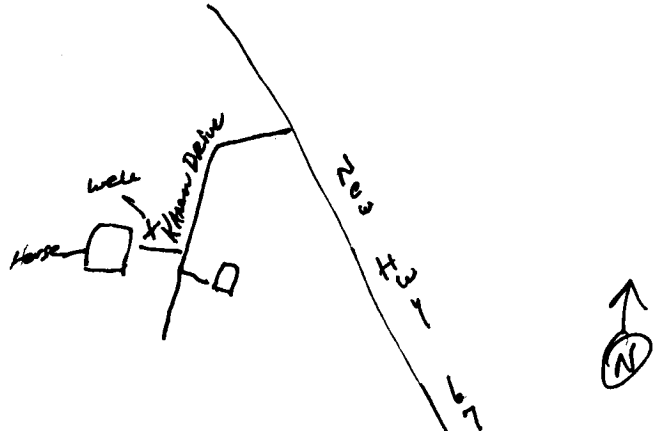

Landowner Name: Dean Fletcher


Jack Kildner  
Signature of Water Well Contractor

RECEIVED  
 D. F. ...  
 OCT 12 2011  
 Lewis Printing - Pascagoula, MS  
 BY: OLWR

Handwritten notes on the left side of the page, possibly including a date or initials.


Handwritten notes in the upper middle section, including the word "TOP" and other illegible characters.

Faint, illegible text at the top right of the page.

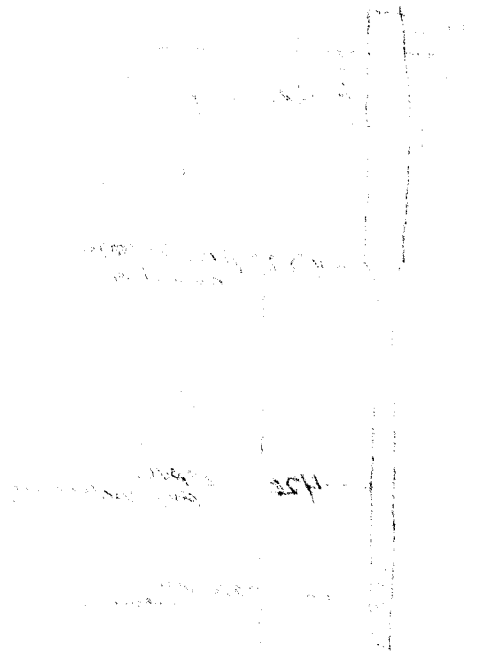

Main body of handwritten text in the middle section, appearing as a list or series of notes.

Text in the lower middle section, possibly a continuation of the notes or a separate section.

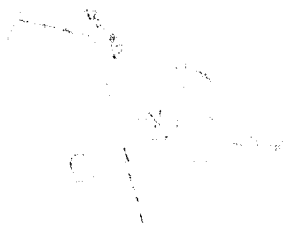

Handwritten text at the bottom right of the page, possibly a signature or a date.

Vertical text on the bottom left side, possibly a stamp or a reference code.

# STATE WELL REPORT

## Part 2

**Pump Installer's Completion Report**  
 Mississippi Department of Environmental Quality  
 Office of Land and Water Resources  
 P.O. Box 10631  
 Jackson, MS 39289-0631  
 (601) 961-5210  
 (601) 354-6938 (fax)

For Office Use Only:

Aquifer: \_\_\_\_\_  
 Well #: H600  
 Elevation: \_\_\_\_\_

County: Harrison  
 Permit #: \_\_\_\_\_  
 Driller: Coast Water Wells Serv.  
 Date completed: 9/29/11

**This report should be prepared by the pump installer in detail and filed with the Department within 30 days of the installation of pump.**

Well Owner Information	Well Location
Owner Name: <u>Dean Fletcher</u>	Latitude: <u>33° 30' 41.76"</u> Longitude: <u>088° 57' 36.66"</u>
Mailing Address: <u>15385 Karen Rd.</u>	Method of Lat/Long (circle one): Conventional Survey, USGS quad, <u>Hand-held GPS</u> , Survey-grade GPS
<u>Biloxi, Ms 39532</u>	<u>NE</u> ¼ <u>NW</u> ¼ Sec <u>23</u> Twn <u>T6S</u> Rng <u>R0W</u>
City State Zip Code	Distance Direction Nearest Town
Telephone No. <u>(228) 861-2430</u>	<u>6</u> Miles <u>n/w</u> of <u>D'Iberville</u>

Pump Type Circle one	Power Type Circle one
Air Lift Jet <u>Submersible</u>	Diesel Engine Gasoline Engine Natural Gas
Bucket Piston Turbine	<u>Electric Motor</u> Hand Tractor PTO
Centrifugal Rotary Flowing Well	Windmill Other (specify): _____
Other (specify): _____	Horse Power Rating of Motor: <u>1 HP</u>
Date Pump Installed: <u>9/30/11</u>	Setting Depth: <u>160 FT Drop pipe</u> feet
Rated Pump Capacity: <u>10</u> Gallons Per Minute	Number of Stages: <u>12</u>

Pump Test Data	Method of Measuring Water Level Circle one
Date Well Tested: <u>9/30/11</u>	<u>Air Line</u> Electric Measuring Line Steel Tape
Static Water Level (A): <u>100</u> Feet Below Land Surface	Other (specify): _____
Pumping Water Level (B): <u>N/A</u> Feet Below Land Surface	For flowing well, measured shut in head: <u>N/A</u> feet
Drawdown [(B) - (A)]: <u>N/A</u> Feet Below Land Surface	Well yielded <u>22</u> GPM with a drawdown of
Test Pumping Rate: <u>12</u> Gallons Per Minute	<u>N/A</u> feet after <u>N/A</u> hours of pumping
Duration of Pump Test (minimum 4 hours): <u>4</u> hours	

I HEREBY CERTIFY that the above statements are true to the best of my knowledge.

Jack Ridgell 0-472 \_\_\_\_\_  
 Print Name of Pump Installer and License No. (if applicable) Signature of Pump Installer

**RECEIVED**  
 OCT 12 2011  
 BY: OLWR