

# State Well Report

## Part 1

Mississippi Department of Environmental Quality  
Office of Land and Water Resources  
P.O. Box 10631  
Jackson, MS 39289-0631  
(601) 961-5210  
(601) 354-6938 (fax)

### For Office Use Only:

Aquifer: H 604  
Well #: \_\_\_\_\_  
L. S. Elevation: \_\_\_\_\_  
E-log #: \_\_\_\_\_

County: Harrison  
Permit #: \_\_\_\_\_  
Driller: Coast Water Wells SRV.  
Date drilling completed: 5-22-12

State Law requires that this report be prepared by the driller in detail and filed with the Department within 30 days of completion of drilling of the well.

Well Owner Information	Well Location
Owner Name: <u>Amanda Waltman</u>	Latitude: <u>30° 32' 6.72"</u> Longitude: <u>089° 00' 15.54"</u>
Mailing Address: <u>Townley Rd.</u>	Method of Lat/Long (circle one): Conventional Survey, USGS quad, <u>(Hand-held GPS)</u> Survey-grade GPS
<u>Biloxi, MS 39532</u> City State Zip Code	<u>NE 1/4 SE 1/4 Sec 8 Twn T6 S Rng R10 W</u>
Telephone No. <u>(228) 324-8636</u>	Distance <u>7</u> Miles Direction <u>NNW</u> of Nearest Town <u>Biloxi</u>

### Well Data

Purpose of Well (circle one) Home Industrial Public Supply Irrigation Fish Culture Other: \_\_\_\_\_

Date well drilling started: 5/21/12 Date well drilling completed: 5/22/12

If flowing, method of flow regulation: Valve N/A Other (describe) \_\_\_\_\_

Static Water Level: 130 feet above or (below) (circle one) land surface Date measured: 5/22/12

Method of Measurement (circle one) steel tape electric tape (air line) other: \_\_\_\_\_

Hole depth: 497 FT Well depth: 497 FT Well grouted to a depth of 10 feet

Type of grout (circle one): Cement (Bentonite) Mix

Casing length: 477 feet Casing diameter: 2 inches Type of casing: PVC

Screen length: 20 feet Screen diameter: 2 inches Type of screen: PVC

Screen slot size: .006 inches Setting depth: From 477 feet to 497 feet

Type of completion (circle all applicable): Gravel packed Underreamed Telescoped Open hole (Natural Development)

Other (describe): \_\_\_\_\_

Top of lap pipe or reduction in casing: N/A feet. If telescoped or more than one screen, describe on back of page

Logs run (circle all applicable) (No log run) Electric Gamma Ray Density Sonic Neutron Other: \_\_\_\_\_

Name of organization running log(s): N/A

I certify that the well was drilled, constructed, and completed in accordance with all applicable requirements of the Mississippi Department of Environmental Quality and/or the Mississippi Department of Health regulations and state laws.

Jack Ridgello-472 **RECEIVED** Jack Ridgello  
Print Name of Water Well Contractor and License No. Signature of Water Well Contractor  
JUN 20 2012

BY: OLWR

4609

If well telescopes please sketch below and show depths.


Ground Level

---

Description of Formations Encountered	From	To
Top Soil	0	2
Orange Clay	2	18
Orange Coarse Sand + Peagravel	18	100
Orange clay	100	165
Blue clay	165	424
Gray Coarse Sand w/peagravel	424	497

If more than one screen, show location of each on sketch

Sketch the property layout and include the following: 1) the well location; 2) any permanent structures on the property that may aid in locating the well; 3) any roads, power lines, or other items that may aid in locating the property and the well; 4) indicate direction.

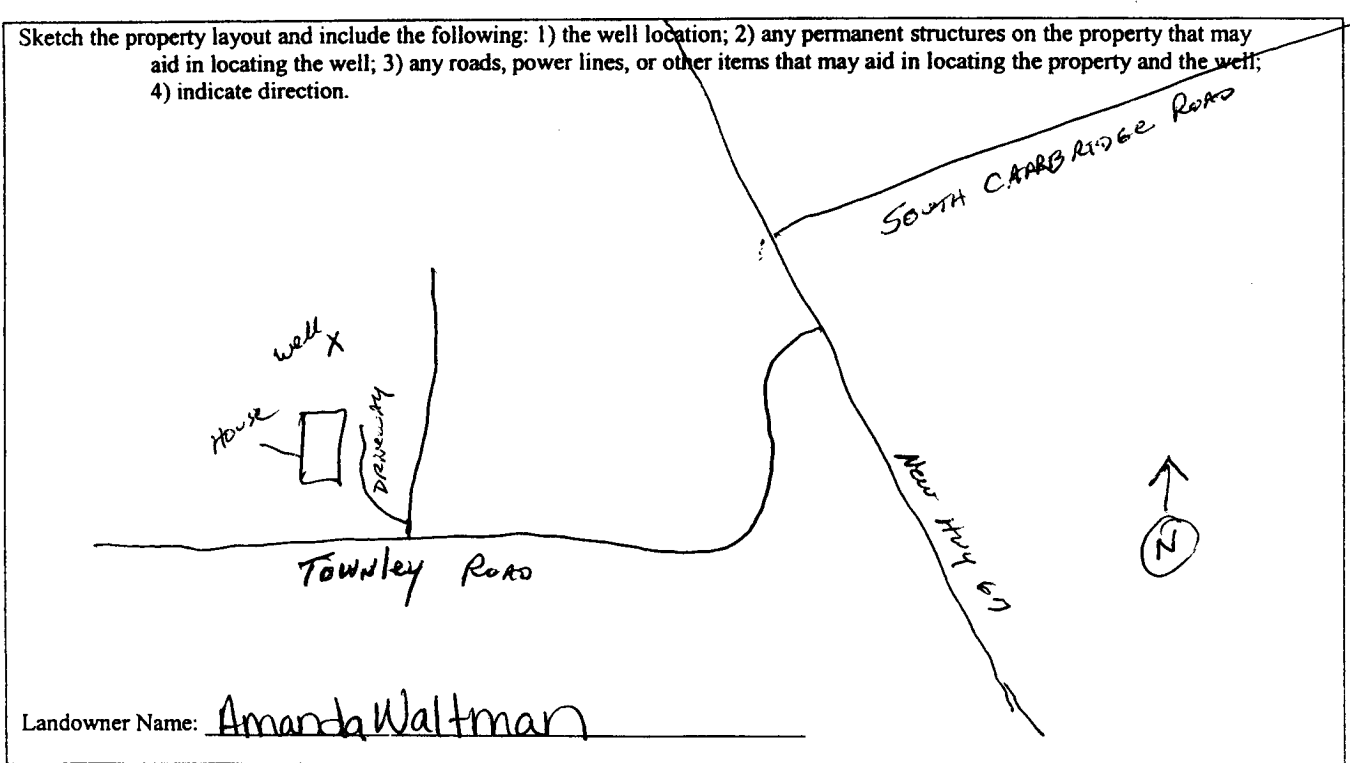

Landowner Name: Amanda Waltman

  
 Signature of Water Well Contractor

RECEIVED

JUN 20 2012

BY: OLWR

H604

# STATE WELL REPORT

## Part 2

**Pump Installer's Completion Report**  
 Mississippi Department of Environmental Quality  
 Office of Land and Water Resources  
 P.O. Box 10631  
 Jackson, MS 39289-0631  
 (601) 961-5210  
 (601) 354-6938 (fax)

For Office Use Only:

Aquifer: \_\_\_\_\_  
 Well #: \_\_\_\_\_  
 Elevation: \_\_\_\_\_

County: Harrison  
 Permit #: \_\_\_\_\_  
 Driller: Coast Water Wells SRV.  
 Date completed: 5-22-12

This report should be prepared by the pump installer in detail and filed with the Department within 30 days of the installation of pump.

Well Owner Information	Well Location
Owner Name: <u>Amanda Waltman</u>	Latitude: <u>30° 32' 6.72"</u> Longitude: <u>089° 00' 15.54"</u>
Mailing Address: <u>Townley Rd.</u>	Method of Lat/Long (circle one): Conventional Survey, USGS quad, <u>Hand-held GPS</u> , Survey-grade GPS
<u>Biloxi, MS 39532</u>	<u>NE 1/4 SE 1/4 Sec 8 Twn T6S Rng R10W</u>
City State Zip Code	Distance Direction Nearest Town
Telephone No. <u>228 334-8636</u>	<u>7 Miles NNW of Biloxi</u>

Pump Type Circle one	Power Type Circle one
Air Lift <input type="radio"/> Jet <input checked="" type="radio"/> Submersible	Diesel Engine <input type="radio"/> Gasoline Engine <input type="radio"/> Natural Gas
Bucket <input type="radio"/> Piston <input type="radio"/> Turbine	<input checked="" type="radio"/> Electric Motor <input type="radio"/> Hand <input type="radio"/> Tractor PTO
Centrifugal <input type="radio"/> Rotary <input type="radio"/> Flowing Well	Windmill <input type="radio"/> Other (specify): _____
Other (specify): _____	Horse Power Rating of Motor: <u>2 HP</u>
Date Pump Installed: <u>5/23/12</u>	Setting Depth: <u>130 FT Drop Pipe</u> feet
Rated Pump Capacity: <u>6</u> Gallons Per Minute	Number of Stages: <u>3</u>

RECEIVED

Pump Test Data	Method of Measuring Water Level Circle one
Date Well Tested: <u>5/23/12</u>	<input checked="" type="radio"/> Air Line <input type="radio"/> Electric Measuring Line <input type="radio"/> Steel Tape
Static Water Level (A): <u>120</u> Feet Below Land Surface	Other (specify): _____
Pumping Water Level (B): <u>N/A</u> Feet Below Land Surface	For flowing well, measured shut in head: <u>N/A</u> feet
Drawdown [(B) - (A)]: <u>N/A</u> Feet Below Land Surface	Well yielded <u>18</u> GPM with a drawdown of
Test Pumping Rate: <u>6</u> Gallons Per Minute	<u>N/A</u> feet after <u>N/A</u> hours of pumping
Duration of Pump Test (minimum 4 hours): <u>24</u> hours	

JUN 20 2012

BY: OLWR

I HEREBY CERTIFY that the above statements are true to the best of my knowledge.  
Jack Ridgell 0-472  
 Print Name of Pump Installer and License No. (if applicable) Jack Ridgell  
Signature of Pump Installer