State Well Report		
	art 1 For Office Use Only:	
Mississippi Department	t of Environmental Quality Aquifer:	
Permit #: Office of Land a	nd Water Resources Nox 10631 Well #:	
	IS 39289-0631 L. S. Elevation:	
	961-5210	
(601) 35	E-log #:	
State Law requires that this report be prepared by the driller in detail and filed with the Department within 30 days of completion of drilling of the well.		
Well Owner Information	Weil Location	
Owner Name (Nat 18 Parker	Latitude: 30.30 29.58 Longitude: 088.54.14.88	
Mailing Address:	Method of Lat/Long (circle one): Conventional Survey,	
	USGS quad, Hand-held GPS Survey-grade GPS	
BIOXI MS 39532 City State Zip Code	SE NE NE Twn T65 Rng R9W	
Telephone No. 208 860-1711	Distance Direction Nearest Town Miles No Art of D'I beeville	
Weli I	Data	
\sim		
Purpose of Well (circle one) (Home) Industrial Public Supply Irrigation Fish Culture Other:		
Date well drilling started: $\frac{11/28/12}{11}$ Date well drilling completed: $\frac{11/29/12}{12}$		
If flowing, method of flow regulation: Valve NA Other (describe)		
Static Water Level:feet above or below circle one) land surface Date measured:29/12		
Method of Measurement (circle one) steel tape electric tape air line other:		
Hole depth: <u>370 FT</u> Well depth: <u>370 FT</u> Well grouted to a depth of <u>10</u> feet		
Type of grout (circle one): Cement Bentonite Mix AOO X 411 PVC Casing length: 50 X 20 feet Casing diameter: 4 X 2 inches Type of casing: PVC		
Screen length: 2 feet Screen diameter: 2 inches Type of screen: PVC		
Screen slot size: 100 inches Setting depth: From <u>350</u> feet to <u>370</u> feet		
Type of completion (circle all applicable): Gravel packed Underreamed Telescoped Open hole Natural Development		
Other (describe):		
Top of lap pipe or reduction in casing: N/A feet. If telescoped or more than one screen, describe on back of page		
Logs run (circle all applicable): No log run Electric Gamma Ray Density Sonic Neutron Other:		
Name of organization running log(s): M/A I certify that the well was drilled, constructed, and completed in accordance with all applicable requirements of the Mississippi		
Department of Environmental Quality and/or the Mississippi Department of Health regulations and state laws.		
Trk Ridadell 0-172 C. Alue SEMEN		
Print Name of Water Well Contractor and License No.	Simplify of Water Water Water PEF 7 1 Block	
Print Name of Water Well Contractor and License No. Signature of Water Well Contractor 2 1 2011		


٠

7

Lewis Printing - P	escargoule MS
--------------------	---------------

H608

If well telescopes please sketch below and show depths.

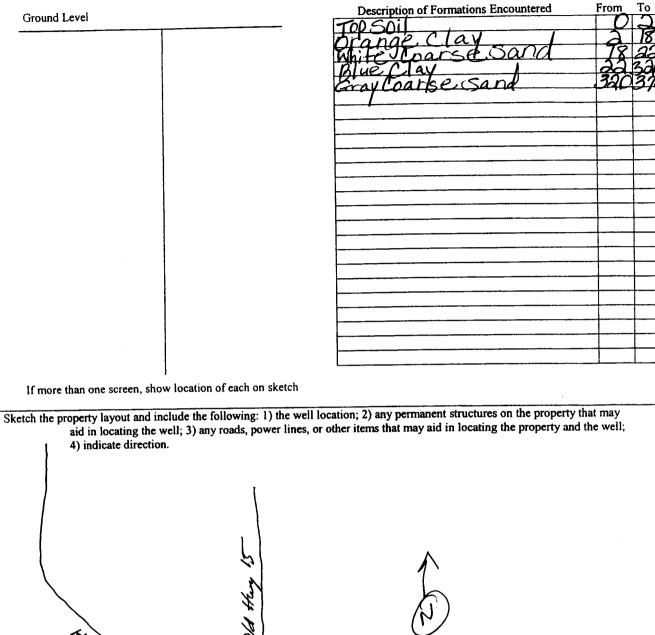

Landowner Name Charles Parker x Eq. Landowner Name Charles Parker x Eq. Dobson Rond BY: OILWER Juel Proposed Signature of Water Well Contractor Lewis Printing - Pascagolia, MS

STATE WELL REPORT		
County: <u>Hatrison</u> Permit #: Driller. <u>00StWaterWall</u> SKV Date completed: <u>II/29//2</u> Pump Installer's Mississippi Departmen Office of Land a P.O. E Jackson, M (601) (601) 3	art 2 For Office Use Only: completion Report Aquifer: t of Environmental Quality Aquifer: md Water Resources Well #: Sox 10631 Well #: IS 39289-0631 Elevation: 961-5210 Elevation:	
This report should be prepared by the pump installer in detail and filed with the Department within 30 days of the installation of pump.		
Well Owner Information Owner Name: <u>WI IS PAR KUR</u> Mailing Address: <u>DObSON Road</u> <u>BilOXI Ms 39532</u> City I State Zip Code Telephone No. <u>OBS 860-1711</u>	Well Location Latitude: <u>20°30'29.58</u> " Longitude <u>88°574'14.88</u> " Method of Lat/Long (circle one): Conventional Survey, USGS quad Hand-held GPS, Survey-grade GPS <u>ME 14 SE 14 Sec 20 Twn T6 S Rng K940</u> <u>SE NE</u> Distance Direction Nearest Town <u>Hand-held GPS</u> Survey-grade GPS	
Pump Type Circle one	Power Type Circle one	
Air Lift Jet Submersible	Diesel Engine Gasoline Engine Natural Gas	
Bucket Piston Turbine	Electric Motor Hand Tractor PTO	
Centrifugal Rotary Flowing Well	Windmill Other (specify):	
Other (specify): Date Pump Installed: Rated Pump Capacity: IZGallons Per Minute	Horse Power Rating of Motor: 141 Setting Depth: 160FT. Drop pipe feet Number of Stages: 15	
Pump Test Data	Method of Measuring Water Level Circle one	
Date Well Tested: 30- 12 Static Water Level (A): Feet Below Land Surface Pumping Water Level (B): Feet Below Land Surface Drawdown [(B) - (A)]: (A Feet Below Land Surface Test Pumping Rate: / 2 Gallons Per Minute	Air Line Electric Measuring Line Steel Tape Other (specify):	
Duration of Pump Test (minimum 4 hours):	NA_feet after NA hours of pumping	
I HEREBY CERTIFY that the above statements are true to the best of my knowledge DEC 2 1 2012 JACK Kingdell O-472 Jack Findplue Print Name of Pump tristaller and License No. (if applicable) Signature of Pump Installer		

¥ , 7

Lewis Printing - Pascagoula, MS