

STATE WELL REPORT

Part 1

Driller's Log

Mississippi Department of Environmental Quality
Office of Land and Water Resources
P.O. Box 2309
Jackson, MS 39225-2309
(601)961-5210
(601)360-0535 (fax)

For Office Use Only:

Well #: H 638
Aquifer: _____
E-Log #: _____

County: Harrison
Permit #: _____
Driller: Coast Water Wells, Inc
Date drilling completed: 12-10-15

State Law requires that this report be prepared by the license holder responsible for the work and filed with the Department at the above address within 30 days of completion of drilling of the well or borehole.

Well Owner Information (Landowner if borehole is not for a water well)	Well or Borehole Location
Owner Name: <u>Mack Murry</u>	Latitude: <u>30° 30' 40.14"</u> Longitude: <u>88° 53' 55.44"</u>
Mailing Address: <u>3694 Rivers Point</u>	Method of Lat/Long (check one): Conventional Survey _____
<u>Biloxi, MS 39532</u>	USGS quad _____ Hand-held GPS <input checked="" type="checkbox"/> Survey-grade GPS _____
City State Zip Code	<u>SW</u> ^{NW} <u>1/4</u> <u>Sec 21</u> <u>T 6 S</u> <u>R 9 W</u>
Telephone No. <u>(601) 310-2860</u>	<u>4</u> Miles <u>North</u> of <u>D'Arbonneville</u>
	(Distance) (Direction) (Nearest Town)

Well / Borehole Data	
Date drilling started: <u>12-10-15</u> Date drilling completed: <u>12-10-15</u> Hole depth: <u>350 FT</u> Hole diameter: <u>2"</u>	
Location of the source of any surface water used for drilling: <u>N/A</u>	
Method of dosing and volume of Chlorine used in drilling and development: <u>1 gal per 1000 drilling 2 gal in well</u>	
Logs run (circle all applicable): <u>No log run</u> Electric Gamma Ray Density Sonic Neutron Other: _____	
Name of organization running log(s): _____	
Purpose of borehole (circle one): <u>Water Well</u> Geotechnical/Geological Investigation Ground Source Heat Pump Seismic Survey Other (describe) _____	
<i>If drilling is not related to water well construction, skip the remainder of this block</i>	
Purpose of Well (circle all applicable): <u>Home</u> Industrial Public Supply Irrigation Fish Culture	
Other (describe): _____	
If a flowing well, method of flow regulation: Valve _____ Other (describe) _____	
Static Water Level: <u>60</u> feet (above or <u>below</u> land surface (circle one) Date measured: <u>12-10-15</u>	
Method of measurement (circle one): Steel tape Electric tape <u>Air line</u> Other (describe): _____	
Well depth: <u>350 FT</u> Well grouted to a depth of: <u>10</u> feet Type of grout (circle one): Neat Cement <u>Bentonite</u> Mix	
Casing length: <u>335</u> feet Casing diameter: <u>2</u> inches Type of casing: <u>PVC</u>	
Screen length: <u>15</u> feet Screen diameter: <u>2</u> inches Type of screen: <u>PVC</u>	
Screen slot size: <u>.006</u> inches Setting depth: From <u>335</u> feet to <u>350</u> feet	
Type of completion (circle all applicable): Gravel packed Underreamed Open hole <u>Natural Development</u>	
Other (describe): _____	
Top of lap pipe or reduction in casing: <u>N/A</u> feet	

If telescoped or more than one screen, describe on next page

Form: OLWR-BWR-1A 4/2016

RECEIVED


OLWR

County: Harrison
 Permit #: _____

For Office Use Only:
 Well #: H 238

The sketch below only required for water wells
If well telescopes, show depths on sketch.

Description of formations encountered must be provided for all wells and boreholes, unless specifically exempted by regulations

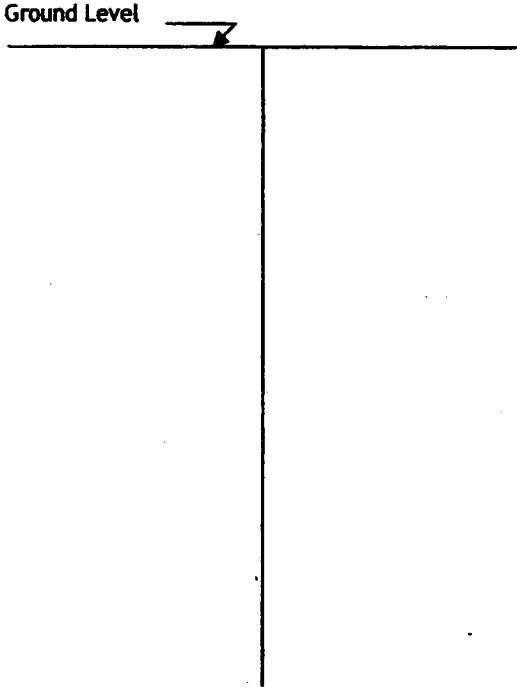


Description of Formations Encountered	From (depth)	To (depth)
Top Soil	Ground level	2
Gray Clay	2	10
White Coarse Sand	10	20
Blue Clay w/streaks of sand	20	23
White Coarse Sand	23	38
Blue Clay	38	315
Gray Coarse Sand	315	350

If more than one screen, show location of each on sketch

Sketch the property layout and include the following:

- 1) the well location
- 2) any permanent structures on the property that may aid in locating the well
- 3) any roads, power lines, or other items that may aid in locating the property and the well
- 4) north arrow

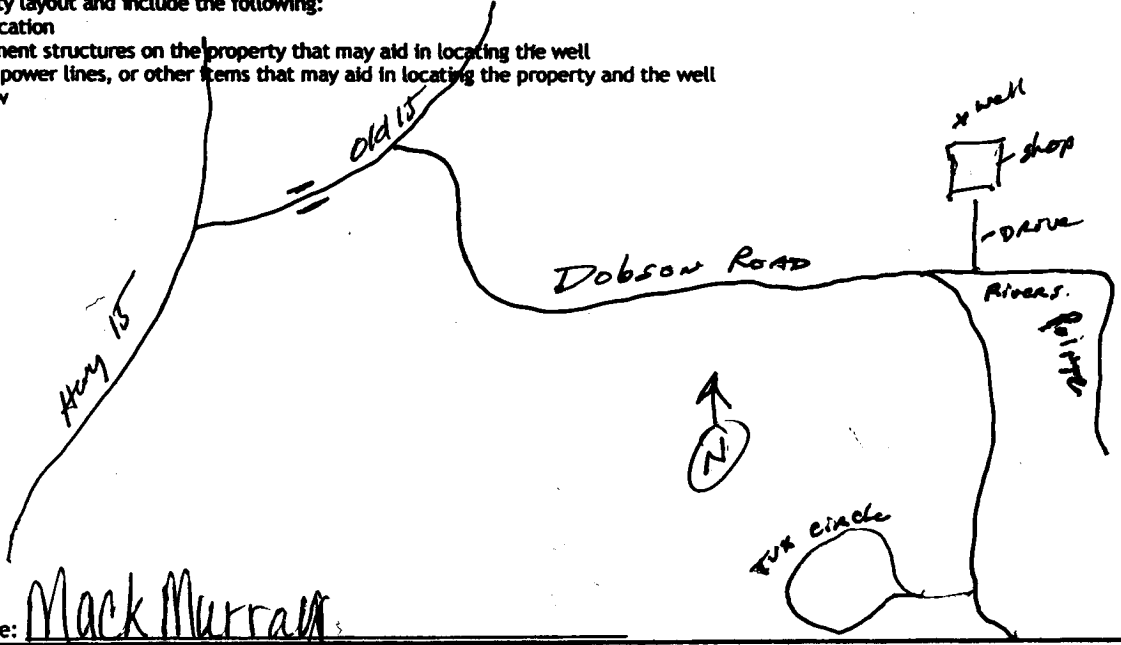

Landowner Name: Mack Murray

I HEREBY CERTIFY that the well/borehole was drilled, constructed, and completed in accordance with all applicable requirements of the Mississippi Department of Environmental Quality and the Mississippi Department of Health regulations, if applicable, and state laws.

Jack Ridgell 0472 12/14/15
 Print Name of Responsible Licensee and License No. Date

Jan Ridgell
 Signature of Licensee

STATE WELL REPORT

Part 2

Pump Installer's Completion Report
 Mississippi Department of Environmental Quality
 Office of Land and Water Resources
 P.O. Box 2309
 Jackson, MS 39225-2309
 (601)961-5210
 (601) 360-0535 (fax)

County: HARRISON
 Permit #: _____
 Driller: East Water Well SVC.
 Date completed: 12-10-15
Copy information from block on Part 1

For Office Use Only:

Well #: 11238
 Aquifer: _____

This part of the report must be completed by a licensed water well contractor or a licensed pump installer. A copy of Part 1 of the report must be attached and both parts filed with the Department at the above address within 30 days of well completion.

Well Owner Information	Well Location
Owner Name: <u>Mack Murry</u>	Latitude: <u>30°30'40.14"</u> Longitude: <u>088°53'55.44"</u>
Mailing Address: <u>3094 Rivers Point</u>	Method of Lat/Long (check one): Conventional Survey _____, USGS quad _____, Hand-held GPS <input checked="" type="checkbox"/> , Survey-grade GPS _____
<u>Piloxi, MS 39532</u>	<u>SW 1/4 NE 1/4, Sec 21 T. 6 S R 9 W</u>
City: _____ State: _____ Zip Code: _____	<u>4</u> Miles <u>NORTH</u> of <u>Disbrow</u>
Telephone No. <u>(601) 310-2860</u>	(Distance) (Direction) (Nearest Town)

Pump Type (circle one)

Submersible Turbine Air Lift Centrifugal Flowing Well Jet Piston Rotary Other (describe): _____

Date Pump Installed: 12-11-15 Rated Pump Capacity: 13 Gallons Per Minute

Is This Pump (circle one): New Repaired Replacement

Power Type (circle one)

Electric Diesel Gasoline Natural Gas Tractor PTO Windmill Other (describe): _____

Horse Power Rating of Motor: 2HP Setting Depth: 80FT DP feet Number of Stages: 3

Pump Test Data for Non Flowing Well

Date Well Tested: 12-11-15 Duration of Pump Test (minimum 4 hours): 6 hours

Static Water Level (A): 60 Feet Below Land Surface Pumping Water Level (B): N/A Feet Below Land Surface

Drawdown [(B) - (A)]: N/A Feet Below Land Surface Test Pumping Rate: 13 Gallons Per Minute

Method of measurement (circle one): Steel tape Electric tape Air line Other (describe): _____

Pump Test Data for Flowing Well

Measured shut in head: _____ feet.

Well yielded _____ GPM with a drawdown of N/A feet after _____ hours of pumping

Meter Installation

Meter Manufacturer: _____ Meter Serial Number: _____

Meter Model Number/Name: N/A Type of Meter: _____

Totalizer Register Unit and Multiplier Factor (AF x .001, gal x 1000, etc): _____

Installation Date: _____ Meter installed by: _____

Is This Meter (circle one): New Repaired Replacement

Important: By submitting the above information you are certifying that this meter was installed to manufacturer standards. For agricultural wells, a list of approved meters is on the MDEQ website.

I HEREBY CERTIFY that the above statements are true to the best of my knowledge.

Jack Bidgell 0-472 12/14/15 [Signature]

Print Name of Pump Installer and License No. (if applicable) Date Signature of Pump Installer