

63

STATE WELL REPORT

Part 1

Driller's Log

Mississippi Department of Environmental Quality
Office of Land and Water Resources
P.O. Box 2309
Jackson, MS 39225-2309
(601)961-5210
(601)360-0535 (fax)

For Office Use Only:

Well #: H697
Aquifer: _____
E-Log #: _____

County: Harrison
Permit #: _____
Driller: East Water Wells, Inc
Date drilling completed: 7-21-21

State Law requires that this report be prepared by the license holder responsible for the work and filed with the Department at the above address within 30 days of completion of drilling of the well or borehole.

Well Owner Information (Landowner if borehole is not for a water well)	Well or Borehole Location
Owner Name: <u>Rick Fayard</u>	Latitude: <u>30° 29' 866"</u> Longitude: <u>088° 56' 288"</u>
Mailing Address: <u>14487 Big John Rd</u>	Method of Lat/Long (check one): Conventional Survey _____ <u>30 29 51</u> <u>88 56 18</u>
<u>Biloxi</u> <u>MS</u> <u>39532</u>	USGS quad _____, Hand-held GPS <input checked="" type="checkbox"/> , Survey-grade GPS _____
City State Zip Code	<u>NW 1/4</u> <u>NE 1/4</u> , Sec <u>25</u> T <u>6S</u> R <u>10W</u>
Telephone No. <u>(228) 348-0571</u>	<u>5</u> Miles <u>NW</u> of <u>Deer Creek</u>
	(Distance) (Direction) (Nearest Town)

Well / Borehole Data

Date drilling started: 7-20-21 Date drilling completed: 7-21-21 Hole depth: 310 FT Hole diameter: 2"

Location of the source of any surface water used for drilling: N/A

Method of dosing and volume of Chlorine used in drilling and development: 1 gal Per 1000 Drilling 2 gal in well

Logs run (circle all applicable): No log run Electric Gamma Ray Density Sonic Neutron Other: _____

Name of organization running log(s): _____

Purpose of borehole (circle one): Water Well Geotechnical/Geological Investigation Ground Source Heat Pump
 Seismic Survey Other (describe) _____

If drilling is not related to water well construction, skip the remainder of this block

Purpose of Well (circle all applicable): Home Industrial Public Supply Irrigation Fish Culture

Other (describe): _____

If a flowing well, method of flow regulation: Valve _____ Other (describe) _____

Static Water Level: 85 feet [above or below] land surface Date measured: 7-21-21

Method of measurement (circle one): Steel tape Electric tape Air line Other (describe): _____

Well depth: 310 FT Well grouted to a depth of: 10 feet Type of grout (circle one): Neat Cement Bentonite Mix

Casing length: 295 feet Casing diameter: 2 inches Type of casing: PVC

Screen length: 15 feet Screen diameter: 2 inches Type of screen: PVC

Screen slot size: .006 inches Setting depth: From 295 feet to 310 feet

Type of completion (circle all applicable): Gravel packed Underreamed Open hole Natural Development

Other (describe): _____

Top of lap pipe or reduction in casing: N/A feet

If telescoped or more than one screen, describe on next page

RECEIVED
JUL 26 2021
BY OLWR


County: Harrison
Permit #: _____

For Office Use Only:
Well #: _____

The sketch below only required for water wells

Description of formations encountered must be provided for all wells and boreholes, unless specifically exempted by regulations


If well telescopes, show depths on sketch.

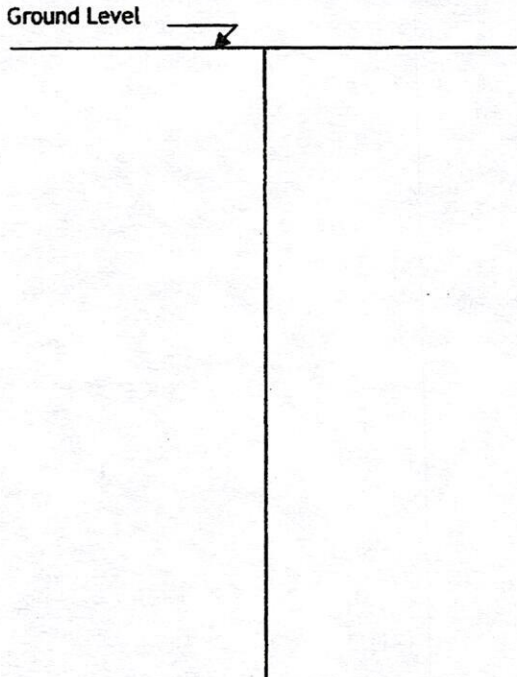

Description of Formations Encountered	From (depth)	To (depth)
Top Soil	Ground level	2
Orange clay	2	15
Orange coarse sand	15	28
Orange clay	28	70
Blue clay	70	110
Brown coarse sand	110	125
Blue clay	125	150
Brown coarse sand	150	165
Blue clay	165	280
Gray coarse sand	280	310

If more than one screen, show location of each on sketch

- Sketch the property layout and include the following:
- 1) the well location
 - 2) any permanent structures on the property that may aid in locating the well
 - 3) any roads, power lines, or other items that may aid in locating the property and the well
 - 4) north arrow

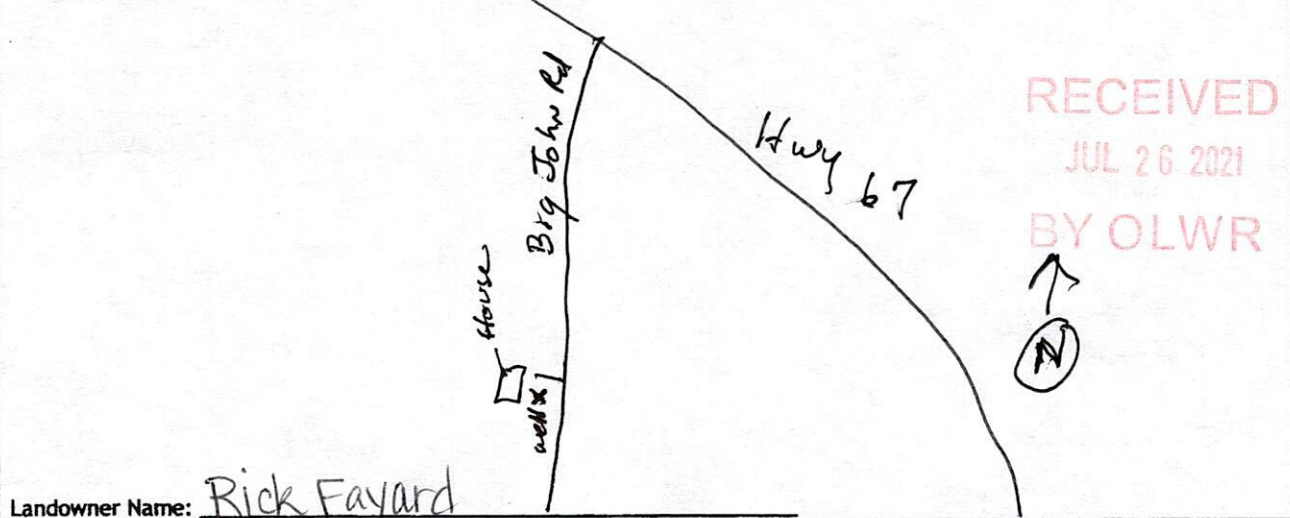

Landowner Name: Rick Fayard

I HEREBY CERTIFY that the well/borehole was drilled, constructed, and completed in accordance with all applicable requirements of the Mississippi Department of Environmental Quality and the Mississippi Department of Health regulations, if applicable, and state laws.

Jack Ridgell 0-472 7/21/21
Print Name of Responsible Licensee and License No. Date Signature of Licensee

STATE WELL REPORT

Part 2

Pump Installer's Completion Report
Mississippi Department of Environmental Quality
Office of Land and Water Resources
P.O. Box 2309
Jackson, MS 39225-2309
(601)961-5210
(601) 360-0535 (fax)

County: Harrison
Permit #: _____
Driller: Coast Waterwell Svc.
Date completed: 7-21-21
Copy information from block on Part 1

For Office Use Only:
Well #: H 697
Aquifer: _____

This part of the report must be completed by a licensed water well contractor or a licensed pump installer. A copy of Part 1 of the report must be attached and both parts filed with the Department at the above address within 30 days of well completion.

Well Owner Information	Well Location
Owner Name: <u>Rick Fayard</u>	Latitude: <u>30° 29' 8.66"</u> Longitude: <u>088° 56' 28.8"</u>
Mailing Address: <u>14487 Big John Road</u>	Method of Lat/Long (check one): Conventional Survey _____, ^{30 29 51} ^{88 56 18}
<u>Biloxi</u> <u>Ms</u> <u>39532</u>	USGS quad _____, Hand-held GPS <input checked="" type="checkbox"/> , Survey-grade GPS _____
City State Zip Code	<u>NW</u> <u>NE</u> <u>SE</u> <u>SW</u> <u>25</u> T <u>6S</u> R <u>10W</u>
Telephone No. <u>(228) 348-0571</u>	<u>5</u> Miles <u>NW</u> of <u>D'Iberville</u>
	(Distance) (Direction) (Nearest Town)

Pump Type (circle one)
Submersible Turbine Air Lift Centrifugal Flowing Well Jet Piston Rotary Other (describe): _____
Date Pump Installed: 7-22-21 Rated Pump Capacity: 10 Gallons Per Minute
Is This Pump (circle one): New Repaired Replacement

Power Type (circle one)
 Electric Diesel Gasoline Natural Gas Tractor PTO Windmill Other (describe): _____
Horse Power Rating of Motor: 2HP Setting Depth: 100FT DP feet Number of Stages: 3

Pump Test Data for Non Flowing Well
Date Well Tested: 7-22-21 Duration of Pump Test (minimum 4 hours): 5 hours
Static Water Level (A): 85 Feet Below Land Surface Pumping Water Level (B): N/A Feet Below Land Surface
Drawdown [(B) - (A)]: N/A Feet Below Land Surface Test Pumping Rate: 10 Gallons Per Minute
Method of measurement (circle one): Steel tape Electric tape Air line Other (describe): _____

Pump Test Data for Flowing Well
Measured shut in head: _____ feet.
Well yielded _____ GPM with a drawdown of N/A feet after _____ hours of pumping 2021

Meter Installation
Meter Manufacturer: N/A Meter Serial Number: BY OLWR
Meter Model Number/Name: _____ Type of Meter: _____
Totalizer Register Unit and Multiplier Factor (AF x .001, gal x 1000, etc): _____
Installation Date: _____ Meter installed by: _____
Is This Meter (circle one): New Repaired Replacement
Important: By submitting the above information you are certifying that this meter was installed to manufacturer standards. For agricultural wells, a list of approved meters is on the MDEQ website.

I HEREBY CERTIFY that the above statements are true to the best of my knowledge.
Jack Ridadell 0-472 7/22/21
Print Name of Pump Installer and License No. (if applicable) Date Signature of Pump Installer