

Harrison
 H 2000
 4-29-74

MISSISSIPPI
 BOARD OF WATER COMMISSIONERS
 416 North State Street
 Jackson, Mississippi 39201

WATER WELL DRILLERS LOG



date well completed 4/29 1974 COASTAL DRILLING & SERVICE CO. Harrison
 county well located
 ROUTE 1 ^{from name} BOX 618

LANDOWNER: Paul White
PT 2 B of 80'
Biloxi, Miss
 (mailing address)

description of formations encountered	from	to
Top Soil	1	3
Red sandy clay	3	25
white sand	25	40
Soft blue clay	40	105
fine white sand	105	120
Soft blue clay	120	140
hard blue clay	140	280
fine white sand	280	385
Coarse white sand	285	345

WELL LOCATION:
 sec 4 T 6 N R 10 E 135
2.7 miles N 2 miles N Cedar Lake
 (distance) (direction) (nearest town)


WELL PURPOSE: Home
 (home, irrigation, municipal, industrial)

WELL COMPLETION DATA:

- (1) diameter (inches) 2"
- (2) total depth (feet) 345'
- (3) static water level (feet) 40 below above top of ground.
- (4) casing 2" PVC, 305'
 (material) (depth)
- _____ if telescope see back.
 (size)
- (5) screen 10' 305'
 (length) (depth to top)
- 2" _____
 (size) (material)
- (6) pump One 12
 (HP) (yield gpm)
- Ele.
 (type power)
- (7) electric log no
 (yes or no)
- _____ (organization running log)

(8) how well bottom plugged
2" lead with well

DRILLERS REMARKS:

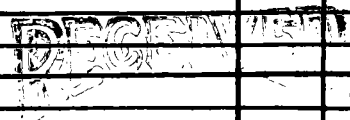

JUL 17 1975

If well telescopes please sketch and show depths.

GROUND LEVEL

SECTION _____

Please indicate well location X.

ADDITIONAL INFORMATION

If more than one screen, show locations of each on sketch.