

Harrison
 H ~~2004~~
 517-75

MISSISSIPPI
 BOARD OF WATER COMMISSIONERS
 416 North State Street
 Jackson, Mississippi 39201

~~CODED~~

WATER WELL DRILLERS LOG
 COASTAL DRILLING & SERVICE CO. *Harrison*
 ROUTE 1 BOX 618
 date well completed *5/12* 19 *75* county well located

BILOXI MISS. 39537

LANDOWNER: *D Jones*

description of formations encountered

from to

Rt 1

<i>top soil</i>	<i>3</i>	<i>3</i>
<i>white sand</i>	<i>2</i>	<i>3.5</i>
<i>soft clay</i>	<i>3.5</i>	<i>6.5</i>
<i>white sand</i>	<i>6.5</i>	<i>10.7</i>
<i>shale</i>	<i>10.7</i>	<i>16.5</i>
<i>hard blue clay</i>	<i>16.5</i>	<i>25.0</i>
<i>fine white sand</i>	<i>25.0</i>	<i>26.0</i>
<i>concretion sand</i>	<i>26.0</i>	<i>28.0</i>

Bilecki Miss
 (mailing address)

WELL LOCATION:
 sec. *32* T. *6* N. R. *10* E. *135*
Old Woomocho
 (distance) (direction) (nearest town)

WELL PURPOSE: *home*
 (home, irrigation, municipal, industrial)

WELL COMPLETION DATA:

- (1) diameter (inches) *2"*
- (2) total depth (feet) *280'*
- (3) static water level (feet) *3* below above top of ground.
- (4) casing *POC* *270'*
 (material) (depth)
- _____ if telescope see back.
 (size)
- (5) screen *10'* *270'*
 (length) (depth to top)
2" *POC*
 (size) (material)
- (6) pump _____
 (HP) (yield gpm)
Elc
 (type power)
- (7) electric log *no*
 (yes or no)

_____ (organization running log)

(8) how well bottom plugged
2" pack with valve


DRILLERS REMARKS:

RECEIVED
 JUL 17 1975

MISS. BD. OF WATER COMM.

If well telescopes please sketch and show depths.

GROUND LEVEL

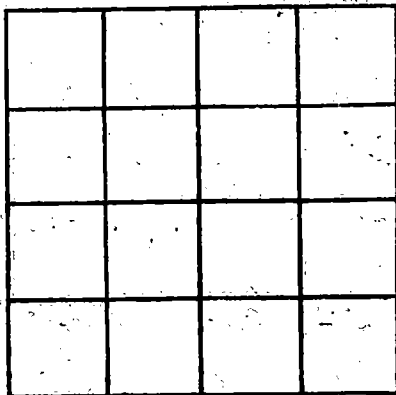

SECTION _____

Please indicate well location X.

ADDITIONAL INFORMATION

If more than one screen, show locations of each on sketch.