

HARRISON
 H 2010
 11-15-76

MISSISSIPPI
 BOARD OF WATER COMMISSIONERS
 416 North State Street
 Jackson, Mississippi 39201

WATER WELL DRILLERS LOG
 COASTAL DRILLING & SERVICE CO.

11/15/76 date well completed ROUTE 1 BOX 692 Harrison county well located

LANDOWNER: Ray Carter
 BILBO, MISS. 39532

PT 1 Box 692
 Bilbo, Miss
 (mailing address)

WELL LOCATION:
 sec 26 T 6 N R 10 E
 S W
 (3) Three miles N of Cedar Lake
 (distance) (direction) (nearest town)

WELL PURPOSE: Home
 (home, irrigation, municipal, industrial)

WELL COMPLETION DATA:

- (1) diameter (inches) 2"
- (2) total depth (feet) 745'
- (3) static water level (feet) 55 below top of ground.
- (4) casing PVC, 735'
 (material) (depth)
 if telescope see back.
 (size)
- (5) screen 10', 735'
 (length) (depth to top)
2", PVC
 (size) (material)
- (6) pump One 1/2
 (HP) (yield gpm)
Ele
 (type power)
- (7) electric log no
 (yes or no)

 (organization running log)

(8) how well bottom plugged
2 inch mesh valve

DRILLERS REMARKS: none

description of formations encountered	from	to
Top Soil	1	2
Red Clay	2	15
White Sand	15	45
White Sand to Rock	45	70
Soft Blue Clay	70	220
fine water sand	220	245
hard blue clay	245	440
fine water sand	440	460
hard blue clay	460	610
fine water sand	610	690
Base water sand	690	745


DISCLAIMER
 MISSISSIPPI BOARD OF WATER COMMISSIONERS

MAR 17 1976

MISS. BD. OF WATER COMMISSIONERS

If well telescopes please sketch and show depths.

GROUND LEVEL

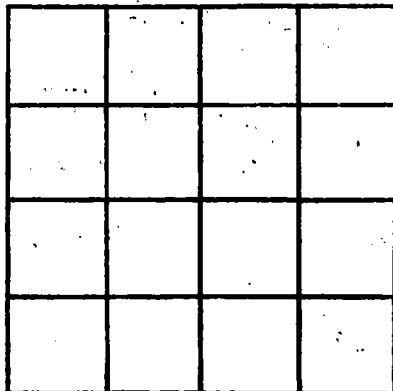

SECTION _____

Please indicate well location X.

ADDITIONAL INFORMATION

If more than one screen, show locations of each on sketch.