

HARRISON
H 2012
12/8/75

MISSISSIPPI
BOARD OF WATER COMMISSIONERS
416 North State Street
135 Jackson, Mississippi 39201

WATER WELL DRILLERS LOG

12/8/75 19 Coastal Drilling Hawaiian
date well completed RT 1 Box 618 Biloxi Miss county well located

LANDOWNER William Asham
RT 1
Biloxi Miss
(mailing address)

description of formations encountered	from	to
Top Soil	1	3
Red Clay	3	30
Green Sand	30	90
Soft Blue Clay	90	110
Stagnant Sand	110	130
fine water sand	130	160


WELL LOCATION:
sec 34 T 6N R 10E
S W
2 1/2 miles E Woodworth
(distance) (direction) (nearest town)

WELL PURPOSE: Home
(home, irrigation, municipal, industrial)

WELL COMPLETION DATA:
(1) diameter (inches) 2"
(2) total depth (feet) 160'
(3) static water level (feet) 30 below above top of ground
(4) casing PVC 155'
(material) (depth)
If telescope see back.
(size)
(5) screen 5' 155'
(length) (depth to top)
2" PVC
(size) (material)
(6) pump (HP) (yield gpm)
(type power)
(7) electric log (yes or no)
(organization running log)

(8) has well bottom plugged
2" hole with valve


DRILLERS REMARKS:
No pump

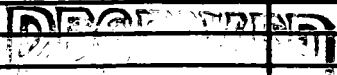

MAR 17 1976

If well telescopes please sketch and show depths.

GROUND LEVEL

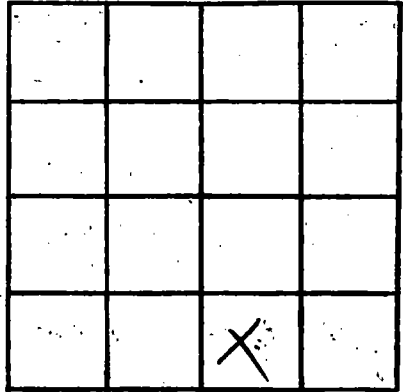

SECTION _____

Please indicate well location X.

ADDITIONAL INFORMATION

If more than one screen,
show locations of each on sketch.