

HARRISON  
H 2015  
3/24/76

MISSISSIPPI  
BOARD OF WATER COMMISSIONERS  
416 North State Street  
Jackson, Mississippi 39201

WATER WELL DRILLERS LOG  
COASTAL DRILLING & SERVICE CO.

3/24 1976 date well completed  
ROUTE 1 BOX 618 well name  
Biloxi MISS. 39532

Harrison county well located

LANDOWNER: John Harrison  
Rt 2 Box 218  
Biloxi Miss  
(mailing address)

description of formations encountered	from	to
top soil	1	3
Red Sand	3	40
Coarse white sand	40	85
Soft Blue Clay	85	150
fine water sand	150	125
Soft Blue Clay	125	200
hard blue clay	200	260
Brown Clay	260	270
hard blue clay	270	380
fine water sand	380	400
Coarse white sand	400	435

WELL LOCATION:  
sec 24 T 6 N R. 10 E  
S W  
(2 1/2) miles N of Cedar Lake  
(distance) (direction) (nearest town)


WELL PURPOSE: Home  
(home, irrigation, municipal, industrial)

- WELL COMPLETION DATA:
- (1) diameter (inches) 2"
  - (2) total depth (feet) 435'
  - (3) static water level (feet) 80 below top of ground
  - (4) casing PVC, 425'  
(material) (depth)
  - (5) screen 10', 425'  
(length) (depth to top)
  - 2", PVC  
(size) (material)
  - (6) pump One, 8  
(HP) (yield gpm)
  - Ele  
(type power)
  - (7) electric log no  
(yes or no)

(organization running log)

(8) how well bottom plugged  
2" back wash valve


DRILLERS REMARKS:

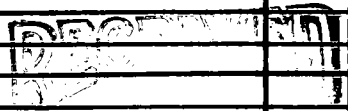

APR - 8 1976

If well telescopes please sketch and show depths.

GROUND LEVEL

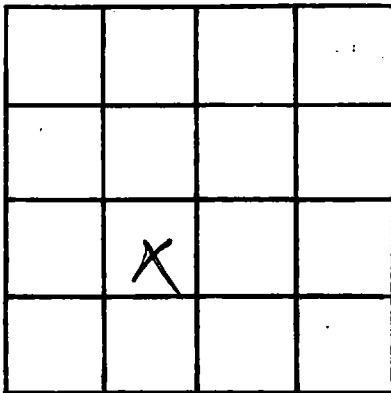

SECTION \_\_\_\_\_

Please indicate well location X.

ADDITIONAL INFORMATION

If more than one screen, show locations of each on sketch.