

HARRISON
H 2016
3-26-76

MISSISSIPPI
 BOARD OF WATER COMMISSIONERS
 416 North State Street
 Jackson, Mississippi 39201

WATER WELL DRILLERS LOG
 COASTAL DRILLING & SERVICE CO.

3/26/76
 date well completed

ROUTE 1 BOX 618

Harrison
 county well located

Donald Jones
 LANDOWNER BILOXI, MISS.

39532

RT 1 Box 690
Biloxi, Miss
 (mailing address)

description of formations encountered	from	to
Top Soil	1	3
Red Clay	3	20
White sand	20	40
Soft blue clay	40	250
hard blue clay	250	280
fine water sand	280	320
hard blue clay	320	400
fine water sand	400	415
Coarse water sand	415	464

WELL LOCATION:

sec 33 T 6 N R 10 E
 S W
Woodward
 miles of (direction) (nearest town)

WELL PURPOSE: Woodward
 (home, irrigation, municipal, industrial)

WELL COMPLETION DATA:

- (1) diameter (inches) 2"
- (2) total depth (feet) 464'
- (3) static water level (feet) 60 below above top of ground.
- (4) casing PVC 454'
 (material) (depth)
- _____ If telescope see back.
 (size)
- (5) screen 10' 454'
 (length) (depth to top)
- 2" PVC
 (size) (material)
- (6) pump One 12
 (HP) (yield gpm)
- Ele
 (type power)
- (7) electric log no
 (yes or no)

_____ (organization running log)


(8) how well bottom plugged
2" black water table

DRILLERS REMARKS:
none

MAR 31 1976
 MISS. BD. OF WATER COMM

If well telescopes please sketch and show depths.

GROUND LEVEL

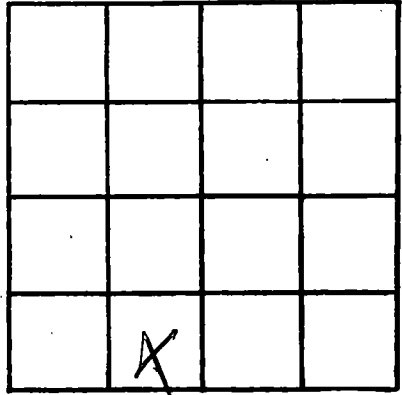

SECTION _____

Please indicate well location X.

ADDITIONAL INFORMATION

If more than one screen,
show locations of each on sketch.