

HARRISON
H 2019
5/13/76

MISSISSIPPI
BOARD OF WATER COMMISSIONERS
 416 North State Street
 Jackson, Mississippi 39201

WATER WELL DRILLERS LOG
COASTAL DRILLING & SERVICE CO.

5/13/76 19 136 ROUTE 1 BOX 618 Harrison
 date well completed firm name county well located
BILOXI, MISS. 39532

LANDOWNER Benny Sallette
Rt 5 Hwy 15
Biloxi, Miss
 (mailing address)

WELL LOCATION:
 sec 32 T 6 N R 9 E
1/2 miles NE of Cedar Lake
 (distance) (direction) (nearest town)

WELL PURPOSE: Home
 (home, irrigation, municipal, industrial)

WELL COMPLETION DATA:

- (1) diameter (inches) 2"
- (2) total depth (feet) 225'
- (3) static water level (feet) 20 below above top of ground.
- (4) casing PVC 225'
 (material) (depth)
- If telescope see back.
 (size)
- (5) screen 10" 225'
 (length) (depth to top)
5" PVC
 (size) (material)
- (6) pump One 15
 (HP) (yield gpm)
Ele
 (type power)
- (7) electric log no
 (yes or no)

 (organization running log)

(8) how well bottom plugged backwash filter

DRILLERS REMARKS:


description of formations encountered	from to	
	feet	feet
<u>Top Soil</u>	<u>1</u>	<u>3</u>
<u>Red Clay</u>	<u>3</u>	<u>1.5</u>
<u>White Sand</u>	<u>75</u>	<u>60</u>
<u>Soft Blue Clay</u>	<u>60</u>	<u>140</u>
<u>White Sand</u>	<u>140</u>	<u>170</u>
<u>Soft Blue Clay</u>	<u>170</u>	<u>200</u>
<u>hard Blue Clay</u>	<u>200</u>	<u>220</u>
<u>Shells</u>	<u>220</u>	<u>225</u>
<u>fine white sand</u>	<u>225</u>	<u>240</u>
<u>hard blue clay</u>	<u>240</u>	<u>280</u>
<u>fine coarse white sand</u>	<u>280</u>	<u>295</u>

DECEASED
DRILLERS
MAY 26 1976

MISS. BD. OF WATER COMMISSIONERS

If well telescopes please sketch and show depths.

GROUND LEVEL

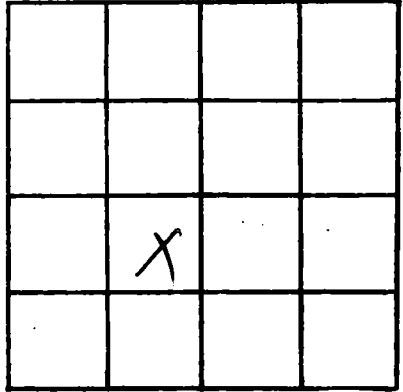

SECTION _____

Please indicate well location X.

ADDITIONAL INFORMATION

If more than one screen, show locations of each on sketch.