

HARRISON
H 2021
6/3/76
6/3/76
 date well completed

MISSISSIPPI
 BOARD OF WATER COMMISSIONERS
 416 North State Street
 Jackson, Mississippi 39201

WATER WELL DRILLERS LOG
 COASTAL DRILLING & SERVICE CO.

ROUTE 1 BOX 618
 BILOXI, MISS 39312

Harrison
 county well located

LANDOWNER By Pearce

description of formations encountered

from to

W 2 Box 275 A
Blair, Miss
 (mailing address)

<u>Top Soil</u>	<u>6</u>	<u>3</u>
<u>Red Clay</u>	<u>3</u>	<u>25</u>
<u>Soft Blue Clay</u>	<u>25</u>	<u>60</u>
<u>(concrete) white sand</u>	<u>60</u>	<u>85</u>
<u>Soft Blue Clay</u>	<u>85</u>	<u>120</u>
<u>Hard Blue Clay</u>	<u>120</u>	<u>280</u>
<u>fine white sand</u>	<u>280</u>	<u>300</u>
<u>(concrete) white sand</u>	<u>300</u>	<u>325</u>

WELL LOCATION:

sec 24 T 6 N R 10 E
S W
(3) Three miles N Blair
 (distance) (direction) (nearest town)

WELL PURPOSE:

Home
 (home, irrigation, municipal, industrial)

WELL COMPLETION DATA:

- (1) diameter (inches) 2"
- (2) total depth (feet) 325'
- (3) static water level (feet) 60 below above top of ground
- (4) casing PVC, 315'
 (material) (depth)
- (5) screen 10', 315'
 (length) (depth to top)
- 2", PVC
 (size) (material)
- (6) pump One, 10
 (HP) (yield gpm)
- Ele
 (type power)
- (7) electric log no
 (yes or no)

(organization running log)

(8) how well bottom plugged

29 feet well plugged

DRILLERS REMARKS:


none

RECEIVED
 JUN 29 1976

MISS. BD. OF WATER COMMISSIONERS

If well telescopes please sketch and show depths.

GROUND LEVEL

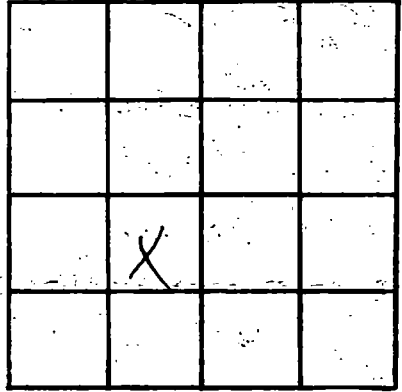

SECTION _____

Please indicate well location X.

ADDITIONAL INFORMATION

If more than one screen, show locations of each on sketch.