

HARRISON  
 H 2024  
 8/9/76  
 8/9/76  
 date well completed

MISSISSIPPI  
 BOARD OF WATER COMMISSIONERS  
 416 North State Street  
 Jackson, Mississippi 39201

WATER WELL DRILLERS LOG  
 COASTAL DRILLING & SERVICE CO.

ROUTE 1 BOX 618  
 MISSISSIPPI

*Adrian*  
 county well located

LANDOWNER: *James Cook*

description of formations encountered

from to

pt 605 A  
 Biloxi, Miss.  
 (mailing address)  
 WELL LOCATION:  
 sec. 34 T 6 N R 10 E  
 S W  
 (2) 1/2 miles East of Woodland  
 (distance) (direction) (nearest town)

|                   |     |     |
|-------------------|-----|-----|
| Top Soil          | 1   | 3   |
| Red Clay          | 3   | 10  |
| White Sand        | 10  | 25  |
| Soft Blue Clay    | 25  | 40  |
| White Sand        | 40  | 90  |
| Clay              | 90  | 95  |
| Soft Blue Clay    | 95  | 230 |
| fine water sand   | 230 | 250 |
| Hard Blue Clay    | 250 | 390 |
| fine water sand   | 390 | 420 |
| Coarse water sand | 420 | 465 |

WELL PURPOSE: *home*  
 (home, irrigation, municipal, industrial)

WELL COMPLETION DATA:

- (1) diameter (inches) 2"
- (2) total depth (feet) 465'
- (3) static water level (feet) 40 below above top of ground.
- (4) casing PVC 4.5'  
 (material) (depth)  
 If telescope see back.  
 (size)
- (5) screen 10' 4.55'  
 (length) (depth to top)  
2" PVC  
 (size) (material)
- (6) pump One 15  
 (HP) (yield gpm)  
Ele  
 (type power)
- (7) electric log no  
 (yes or no)  
 (organization running log)


(8) how well bottom plugged  
*Dr. Cook*  
 DRILLERS REMARKS: *Full*

**RECEIVED**  
 AUG 27 1976

MISS. BD. OF WATER COMM

If well telescopes please sketch and show depths.

GROUND LEVEL

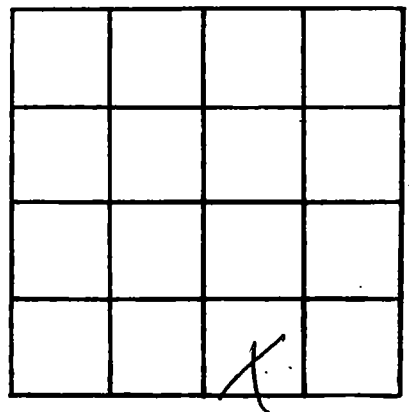

SECTION \_\_\_\_\_

Please indicate well location X.

ADDITIONAL INFORMATION

Lined area for additional information.

If more than one screen, show locations of each on sketch.