

Harrison
 H 2025
 Aug 10, 1976
 8/10/76

MISSISSIPPI
 BOARD OF WATER COMMISSIONERS
 416 North State Street
 Jackson, Mississippi 39201

WATER WELL DRILLERS LOG
 COASTAL DRILLING & SERVICE CO.

Harrison
 county well located

1980 ROUTE 1 BOX 618
 date well completed

LANDOWNER: Harris Plummer
 Rt 1 Dunbarwood Jct
 Bales, Miss
 (mailing address)

| description of formations encountered | from | to |
|---------------------------------------|------|-----|
| top soil | 1 | 3 |
| Red clay | 3 | 15 |
| Coarse white sand | 15 | 25 |
| Soft blue clay | 25 | 60 |
| Light white sand | 60 | 75 |
| Soft blue clay | 75 | 230 |
| Hard blue clay | 230 | 270 |
| fine white sand | 270 | 280 |
| Chase water sand | 280 | 305 |

WELL LOCATION:
 sec 29 T 6 N R 10 E
 1/2 East Woodmarket
 (distance) (direction) (nearest town)

WELL PURPOSE: Home
 (home, irrigation, municipal, industrial)

- WELL COMPLETION DATA:
- (1) diameter (inches) 2"
 - (2) total depth (feet) 305
 - (3) static water level (feet) 56' below top of ground
 - (4) casing PVC 295'
 (material) (depth)
2" if telescope see back.
 (size)
 - (5) screen 20' 295'
 (length) (depth to top)
2" PVC
 (size) (material)
 - (6) pump One 62
 (HP) (yield gpm)
Ele
 (type power)
 - (7) electric log no
 (yes or no)
- (organization running log)

(8) How well bottom plugged
2" black water valve


DRILLERS REMARKS:

RECEIVED
 AUG 27 1976

MISS. BD. OF WATER COMMISSIONERS

If well telescopes please sketch and show depths.

GROUND LEVEL

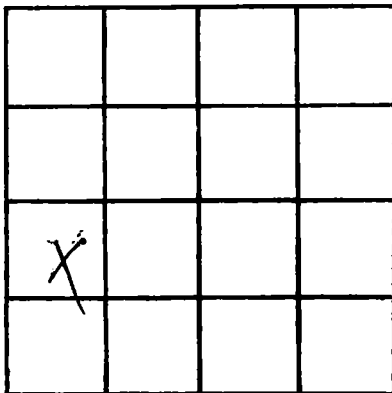

SECTION _____

Please indicate well location X.

ADDITIONAL INFORMATION

Lined area for additional information.

If more than one screen, show locations of each on sketch.