

HARRISON
H 228
8/10/76

MISSISSIPPI
BOARD OF WATER COMMISSIONERS
416 North State Street
Jackson, Mississippi 39201

WATER WELL DRILLERS LOG
COASTAL DRILLING & SERVICE CO.

8/10
date well completed

1976
ROUTE 1 BOX 618
Biloxi, Miss. 39532

Harrison
county well located

LANDOWNER: Harrison

Plummer Rt 1
Biloxi, Miss
(mailing address)

description of formations encountered

from to

Top Soil	1	3
Red Clay	3	15
White Sand	15	30
Swamp Sand	30	45
Soft Blue Clay	45	180
Hard Water Sand	180	200
Hard Blue Clay	200	280
Hard Water Sand	280	290
Coarse Water Sand	290	345

WELL LOCATION:

sec. 32 T. 10 S. R. 10 E. W.
Woodmarket
(distance) (direction) (nearest town)

WELL PURPOSE:

Home
(home, irrigation, municipal, industrial)

WELL COMPLETION DATA:

- (1) diameter (inches) 2"
- (2) total depth (feet) 345'
- (3) static water level (feet) 50 below above top of ground.
- (4) casing PVC, 305'
(material) (depth)
- (5) screen 10', 305'
(length) (depth to top)
- 2"
(size) PVC
(material)
- (6) pump One, 10
(HP) (yield gpm)
- Ele
(type power)
- (7) electric log No
(yes or no)

(organization running log)

(8) How well bottom plugged 2"
Block Wash Valve


DRILLERS REMARKS:

RECEIVED
FEB 4 1977

MISS. BD. OF WATER COMM

If well telescopes please sketch and show depths.

GROUND LEVEL

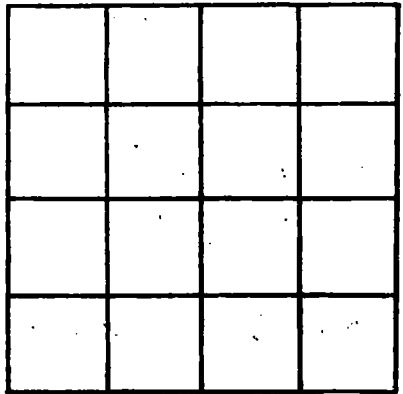

SECTION _____

Please indicate well location X.

ADDITIONAL INFORMATION

If more than one screen, show locations of each on sketch.